


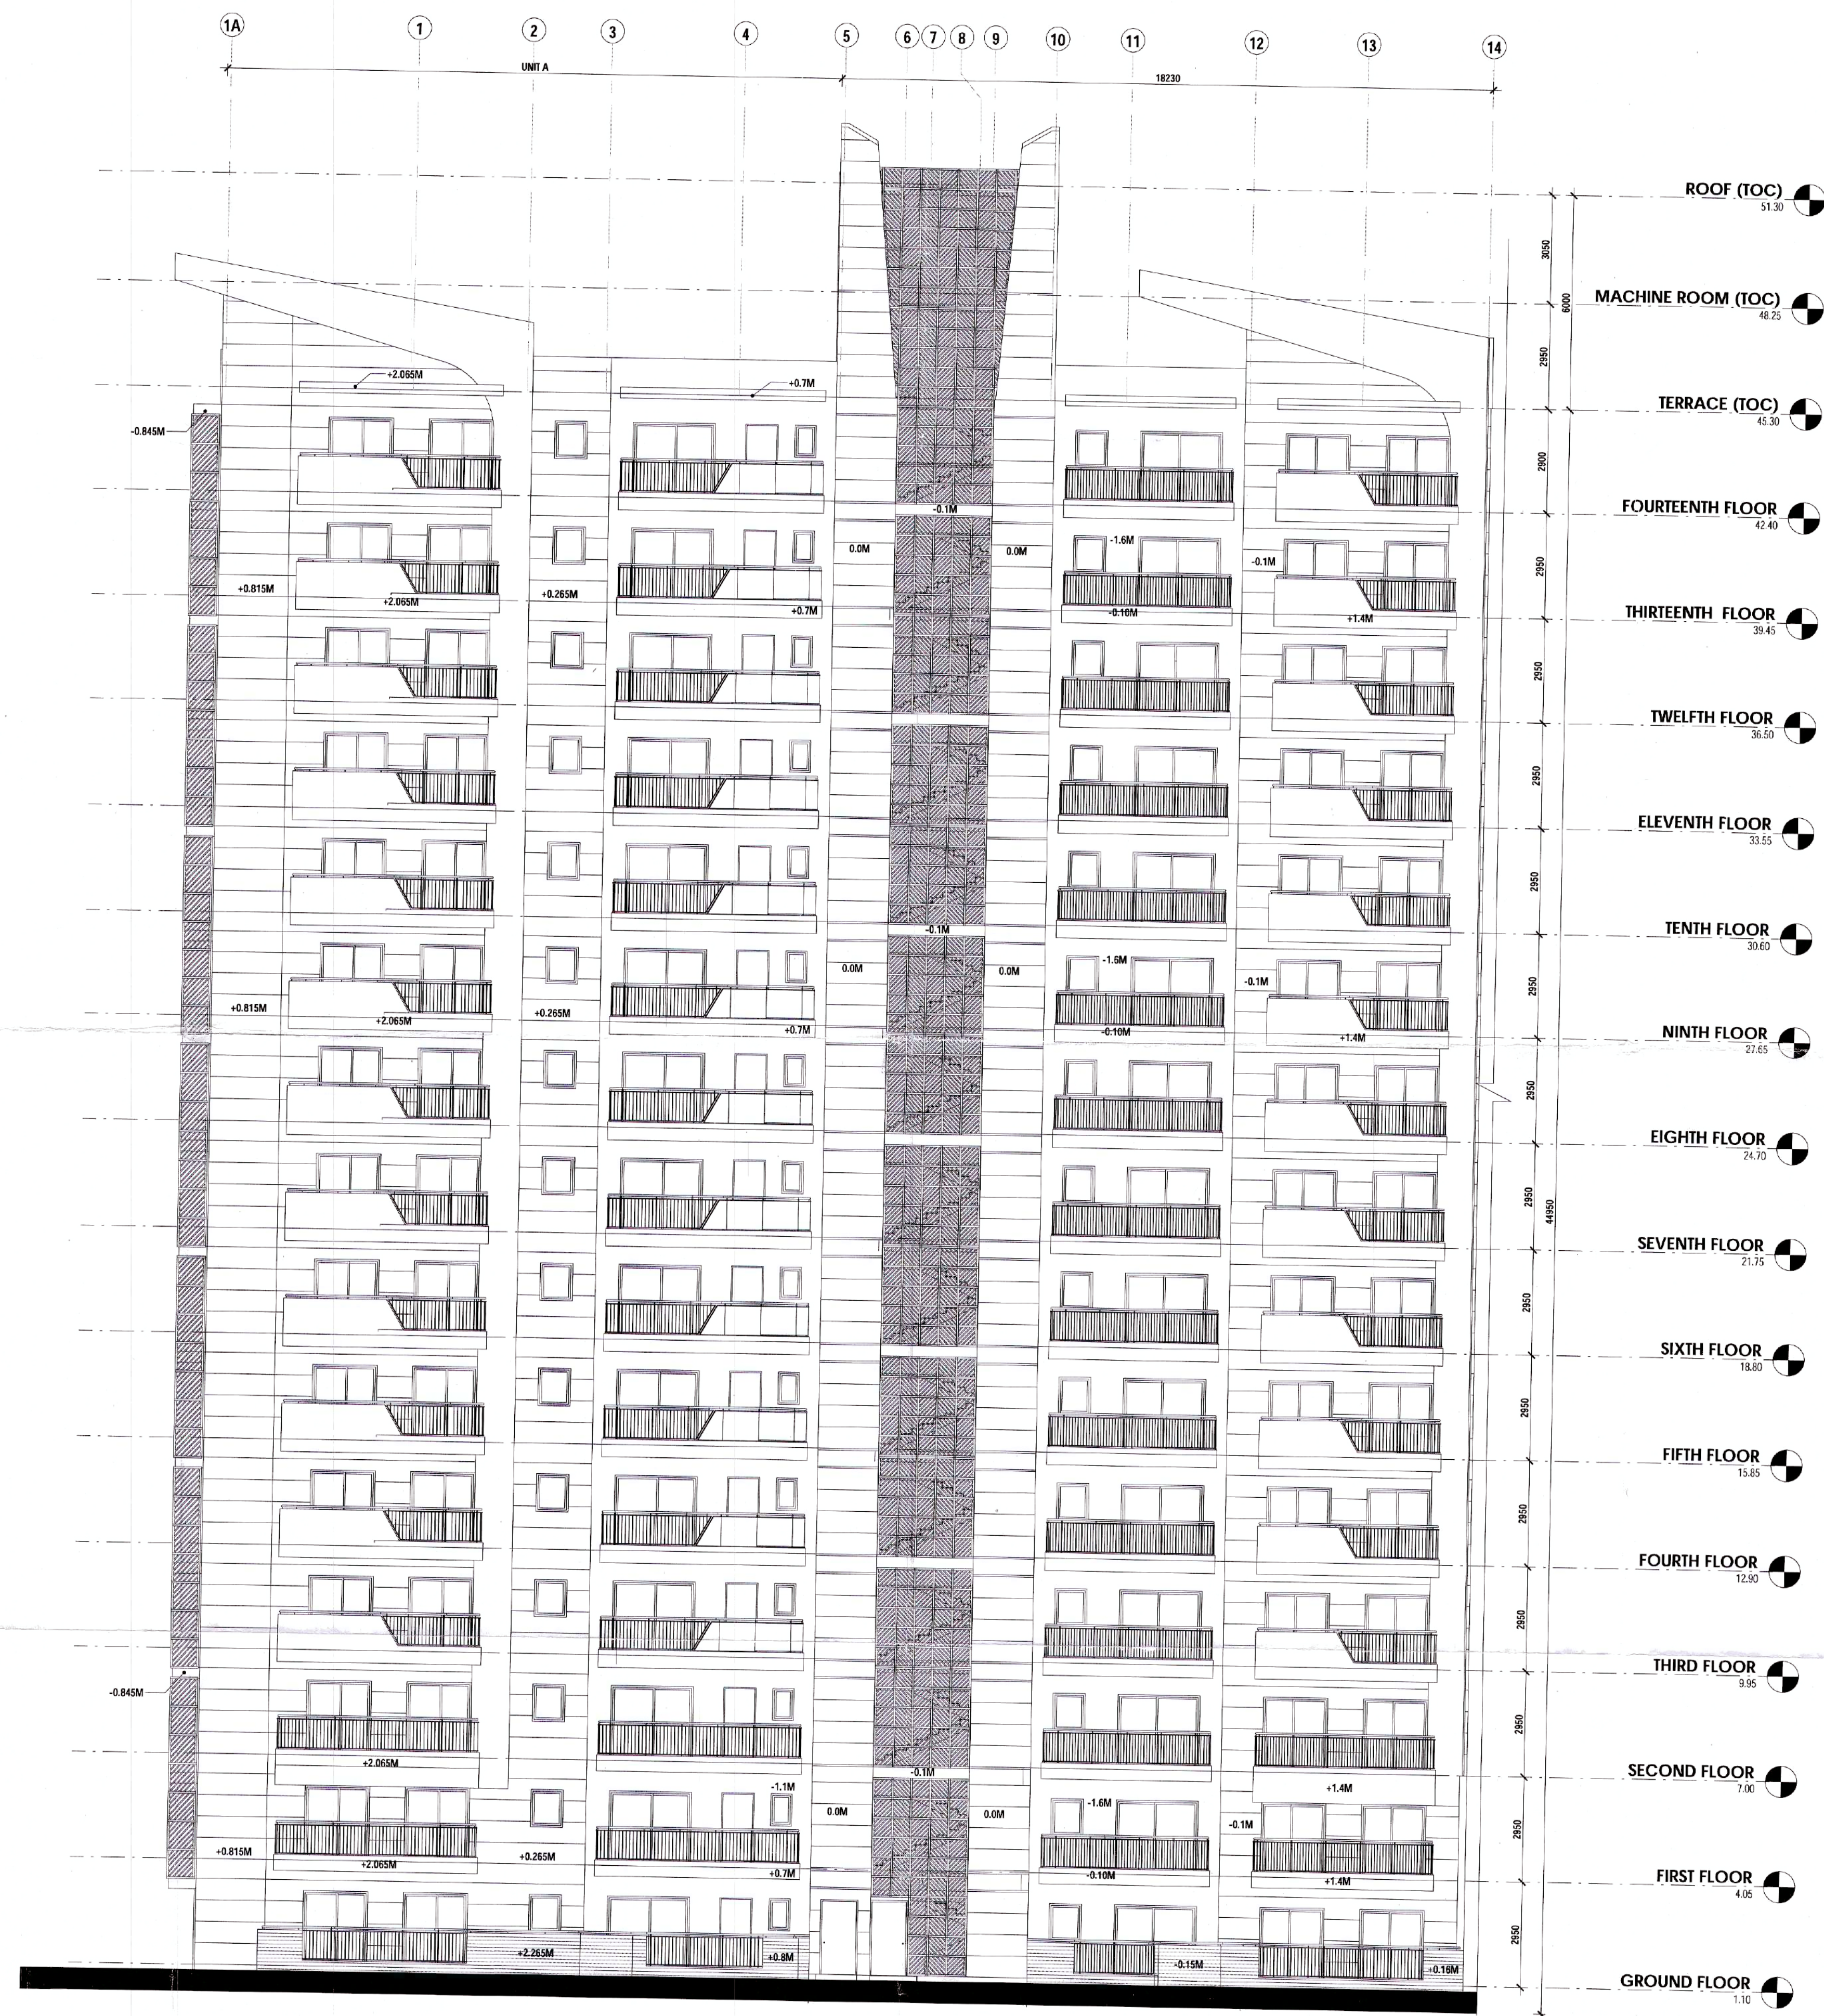

JE *[Signature]*

JD *[Signature]*

ATP *[Signature]*

DTP *[Signature]*

Client/Developer
ASHIANA HOUSING, SOHNA

Architect
BIAS
ARCHITECTURE
601, Tower No. 24, Commonwealth Games Village, New Delhi 110 092
Phone: +91 11 48050933
Email: projects@biasinternational.com

MEP Consultant
V.S. Kulkarni & Associates Pvt. Ltd.
155-A, Gaurdham Nagar
New Delhi 110049

Structure Consultant
Oviect consultants Pvt. Ltd.
A-45, Sector 04
Noida (UP) 201301
Phone: +91 120 4131184

Landscape Consultant
N.M.P. Design Pvt. Ltd.
D-75, Freedom Fighter Colony,
IGNOU Road, Near Sarai, Near Saket
New Delhi 110026
Phone: 011-26535543


Disclaimer
Drawings and written material appearing herein constitute original and unpublished work of the Architect and may not be duplicated, used or disclosed without written consent of the Architect.

Drawing Status

AS-BUILT DRAWINGS

Architect's Signature
ASHWINI PARASHAR
CA/2003/32346

Client's Signature
[Signature]

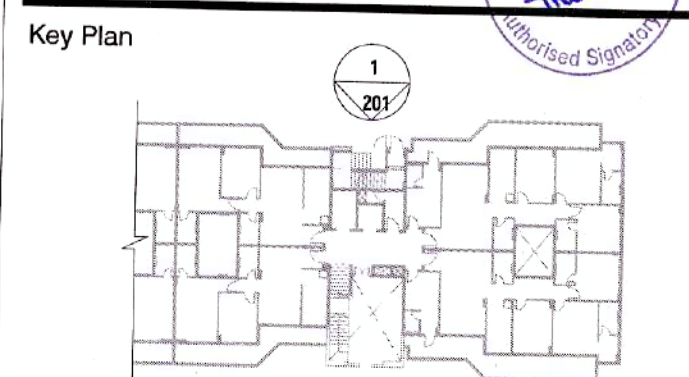

Project Name
PROPOSED BUILDING PLAN OF GROUP HOUSING SCHEME MEASURING 13.3375 ACRES (LICENCE NO. 20 OF 2014 DATED 11.06.2014) IN SECTOR-33, SOHNA BEING DEVELOPED BY UNIVERSE HEIGHTS (INDIA) PVT. LTD.

Project Address
Group Housing Project
Sector 33
Sohna, Haryana.

Drawing Title
TOWER AC NORTH ELEVATION

Project No. 11.12.R

Scale As indicated

Date JAN 07, 2019

Drawing No

201