



Client/Developer
ASHIANA HOUSING LIMITED

Architect
BIAS ARCHITECTURE
Bias+ Architecture
601, Tower No. 24, Commonwealth Games Village, New Delhi 110 002
Phone +91 11 49060933
Email projects@biasarchitecture.com

MEP Consultant
V.S. Kureja & Associates Pvt. Ltd.
165-A, Gauraham Nagar
New Delhi 110049

Structure Consultant
Civil Consultants Pvt. Ltd.
A-45, Sector 04
Noida (UP) 201301
Phone +91 120 4131184

Electrical Consultant
V.S. Kureja & Associates Pvt. Ltd.
165-A, Gauraham Nagar
New Delhi 110049

Fire Fighting Consultant
V.S. Kureja & Associates Pvt. Ltd.
165-A, Gauraham Nagar
New Delhi 110049


Disclaimer
Drawings and written material appearing herein constitute original and unpublished work of the Architect and may not be duplicated, used or disclosed without written consent of the Architect.

Drawing Status

AS-BUILT DRAWINGS

Architect's Signature
ASHWINI PARASHAR
CA/2003/32346

Client's Signature
ASHIANA HOUSING LIMITED

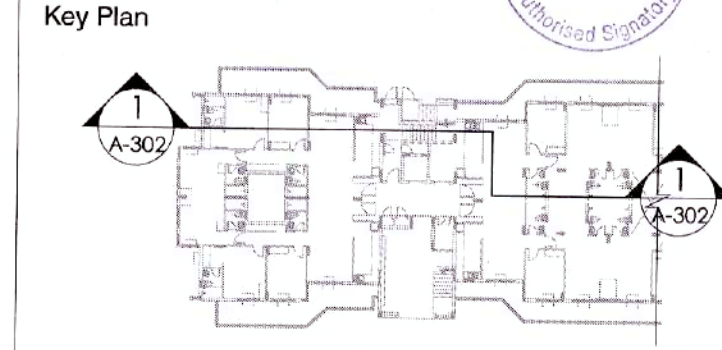

Project Name
AS BUILT BUILDING PLAN OF GROUP HOUSING SCHEME MEASURING 13.3375 ACRES (LICENCE NO. 20 OF 2014 DATED 11.06.2014) IN SECTOR-33, SOHNA BEING DEVELOPED BY ASHIANA HOUSING LIMITED (UNDER JOINT DEVELOPMENT AND MARKETING RIGHTS PERMISSION FROM DTCP)

Project Address
Group Housing Project
Sector 33
Sohna, Haryana.

Drawing Title
TOWER BC SECTION

Project No. 11.12.R

Scale As indicated

Date JAN 07, 2019

Drawing No. **302**

JE ✓

JD ✓

ATP ✓

DTP ✓