



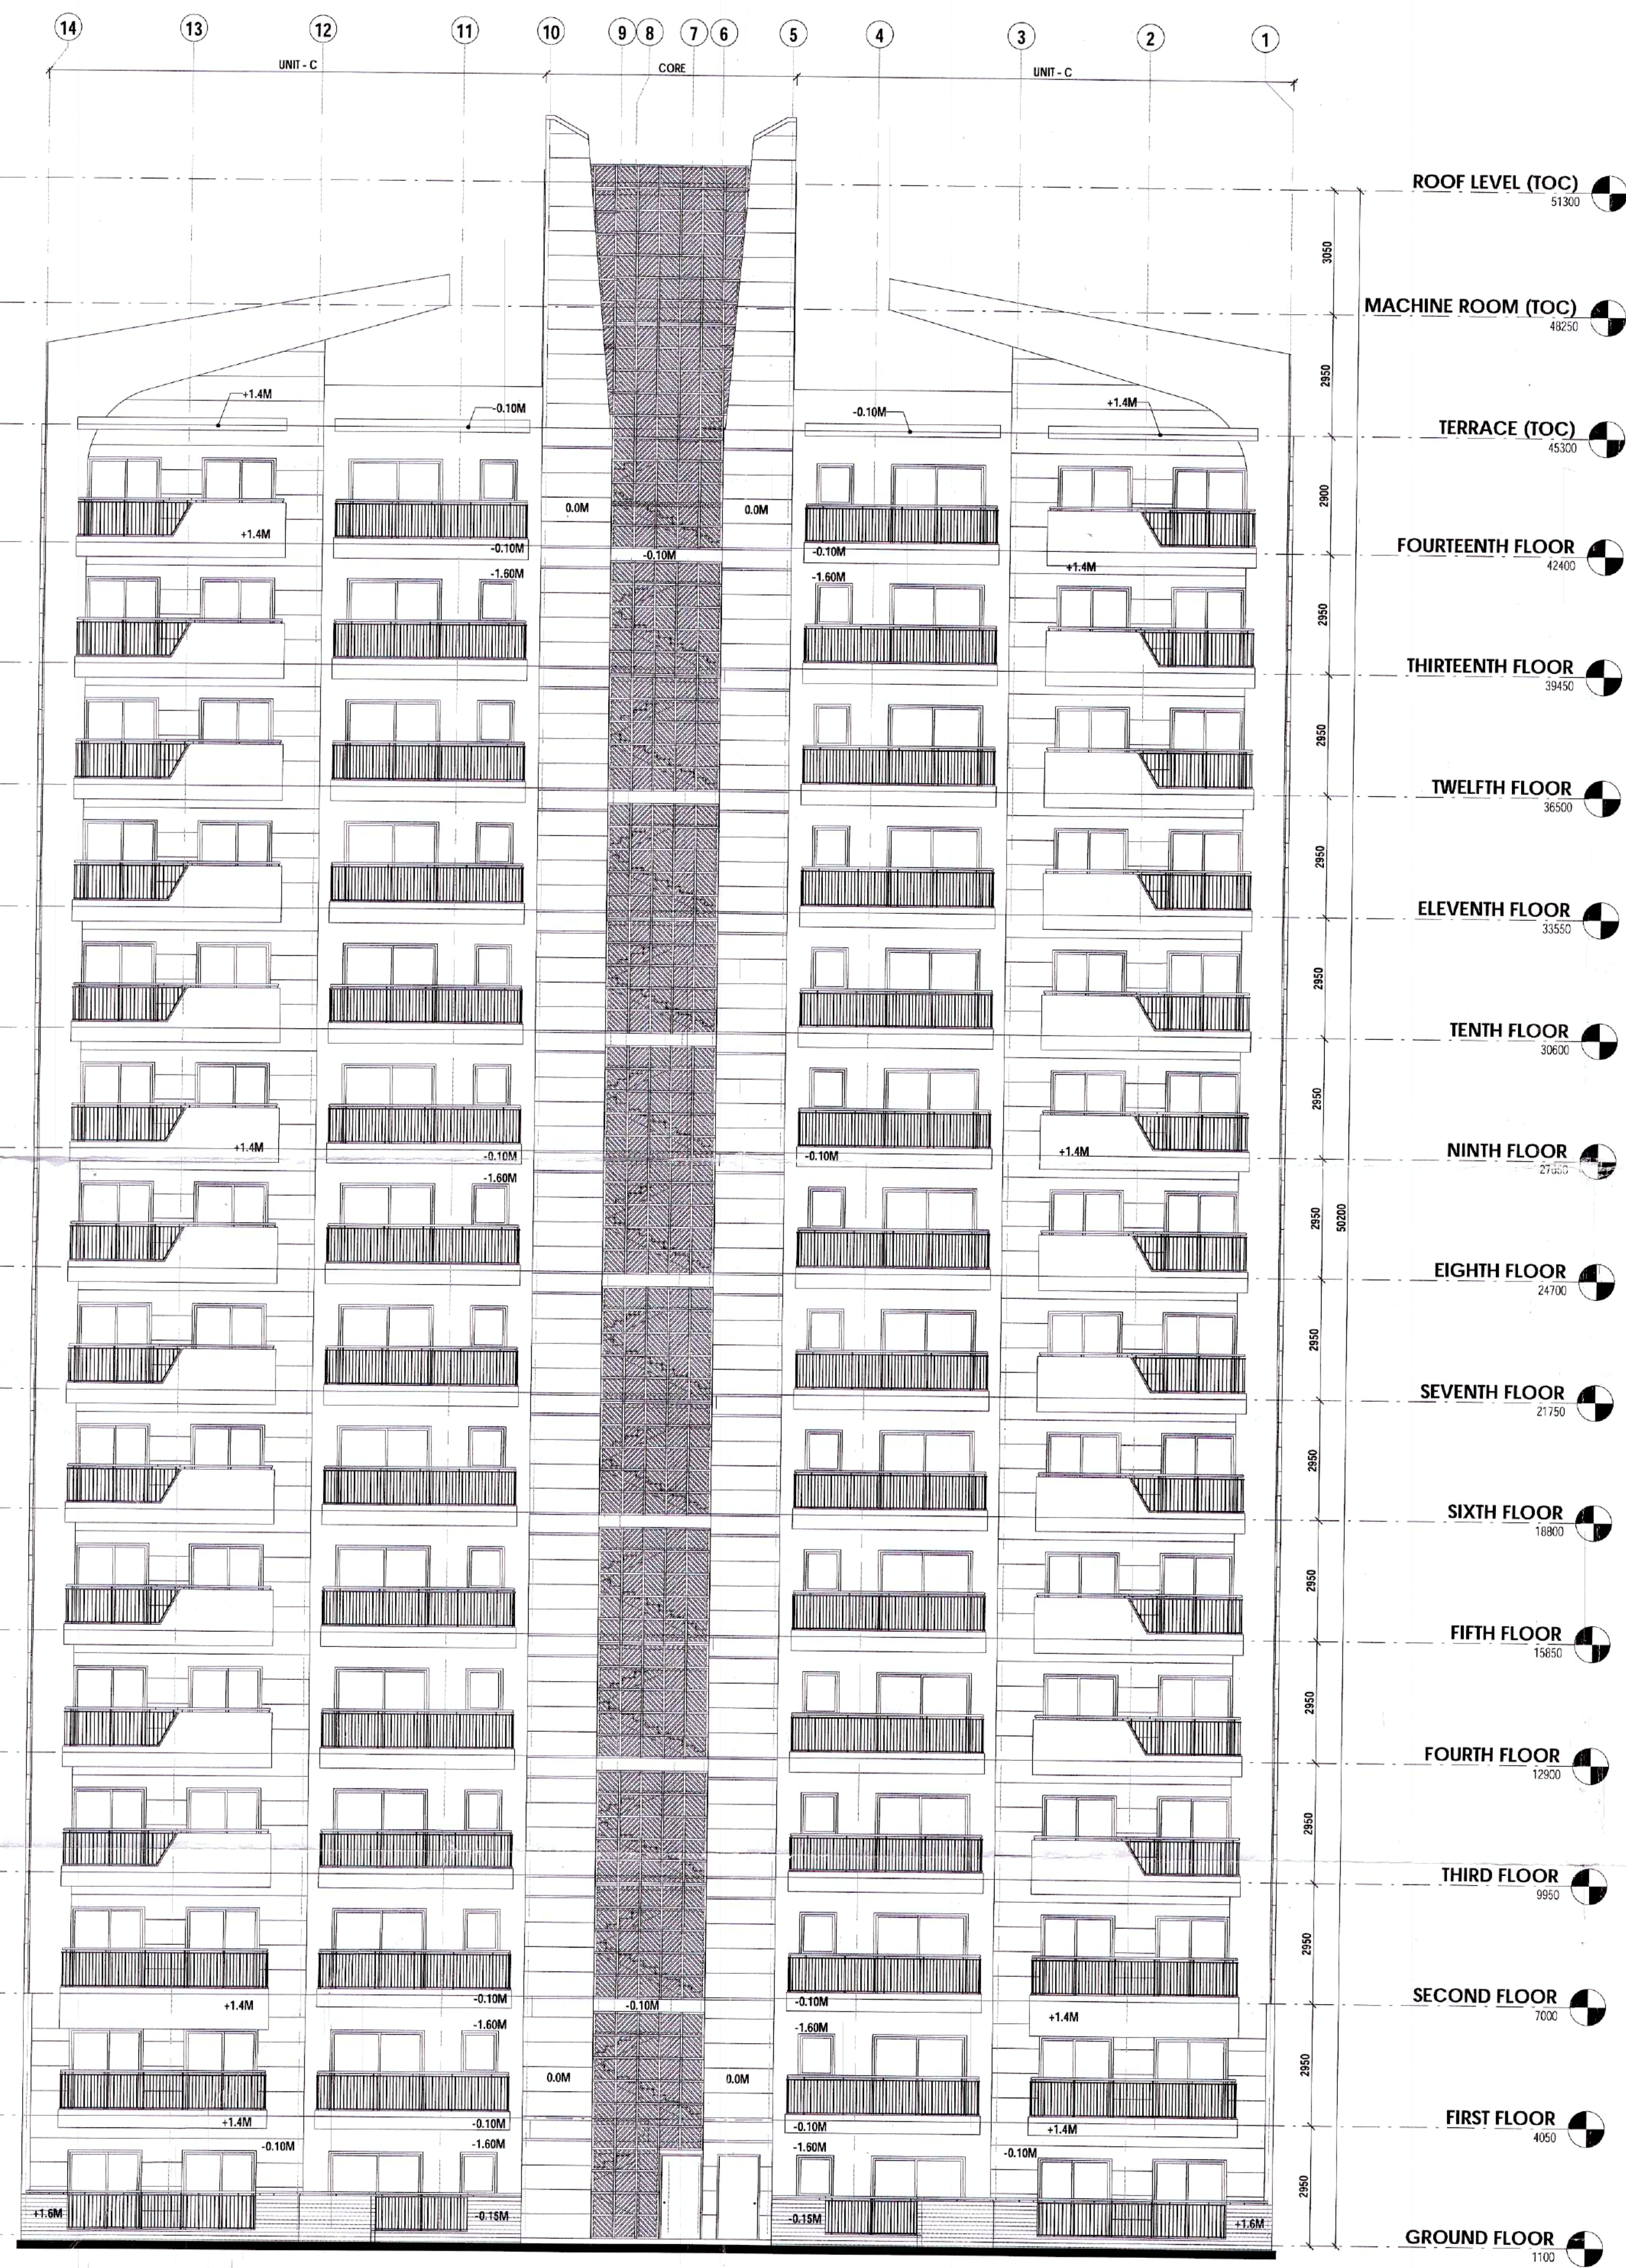

1 North
1:110

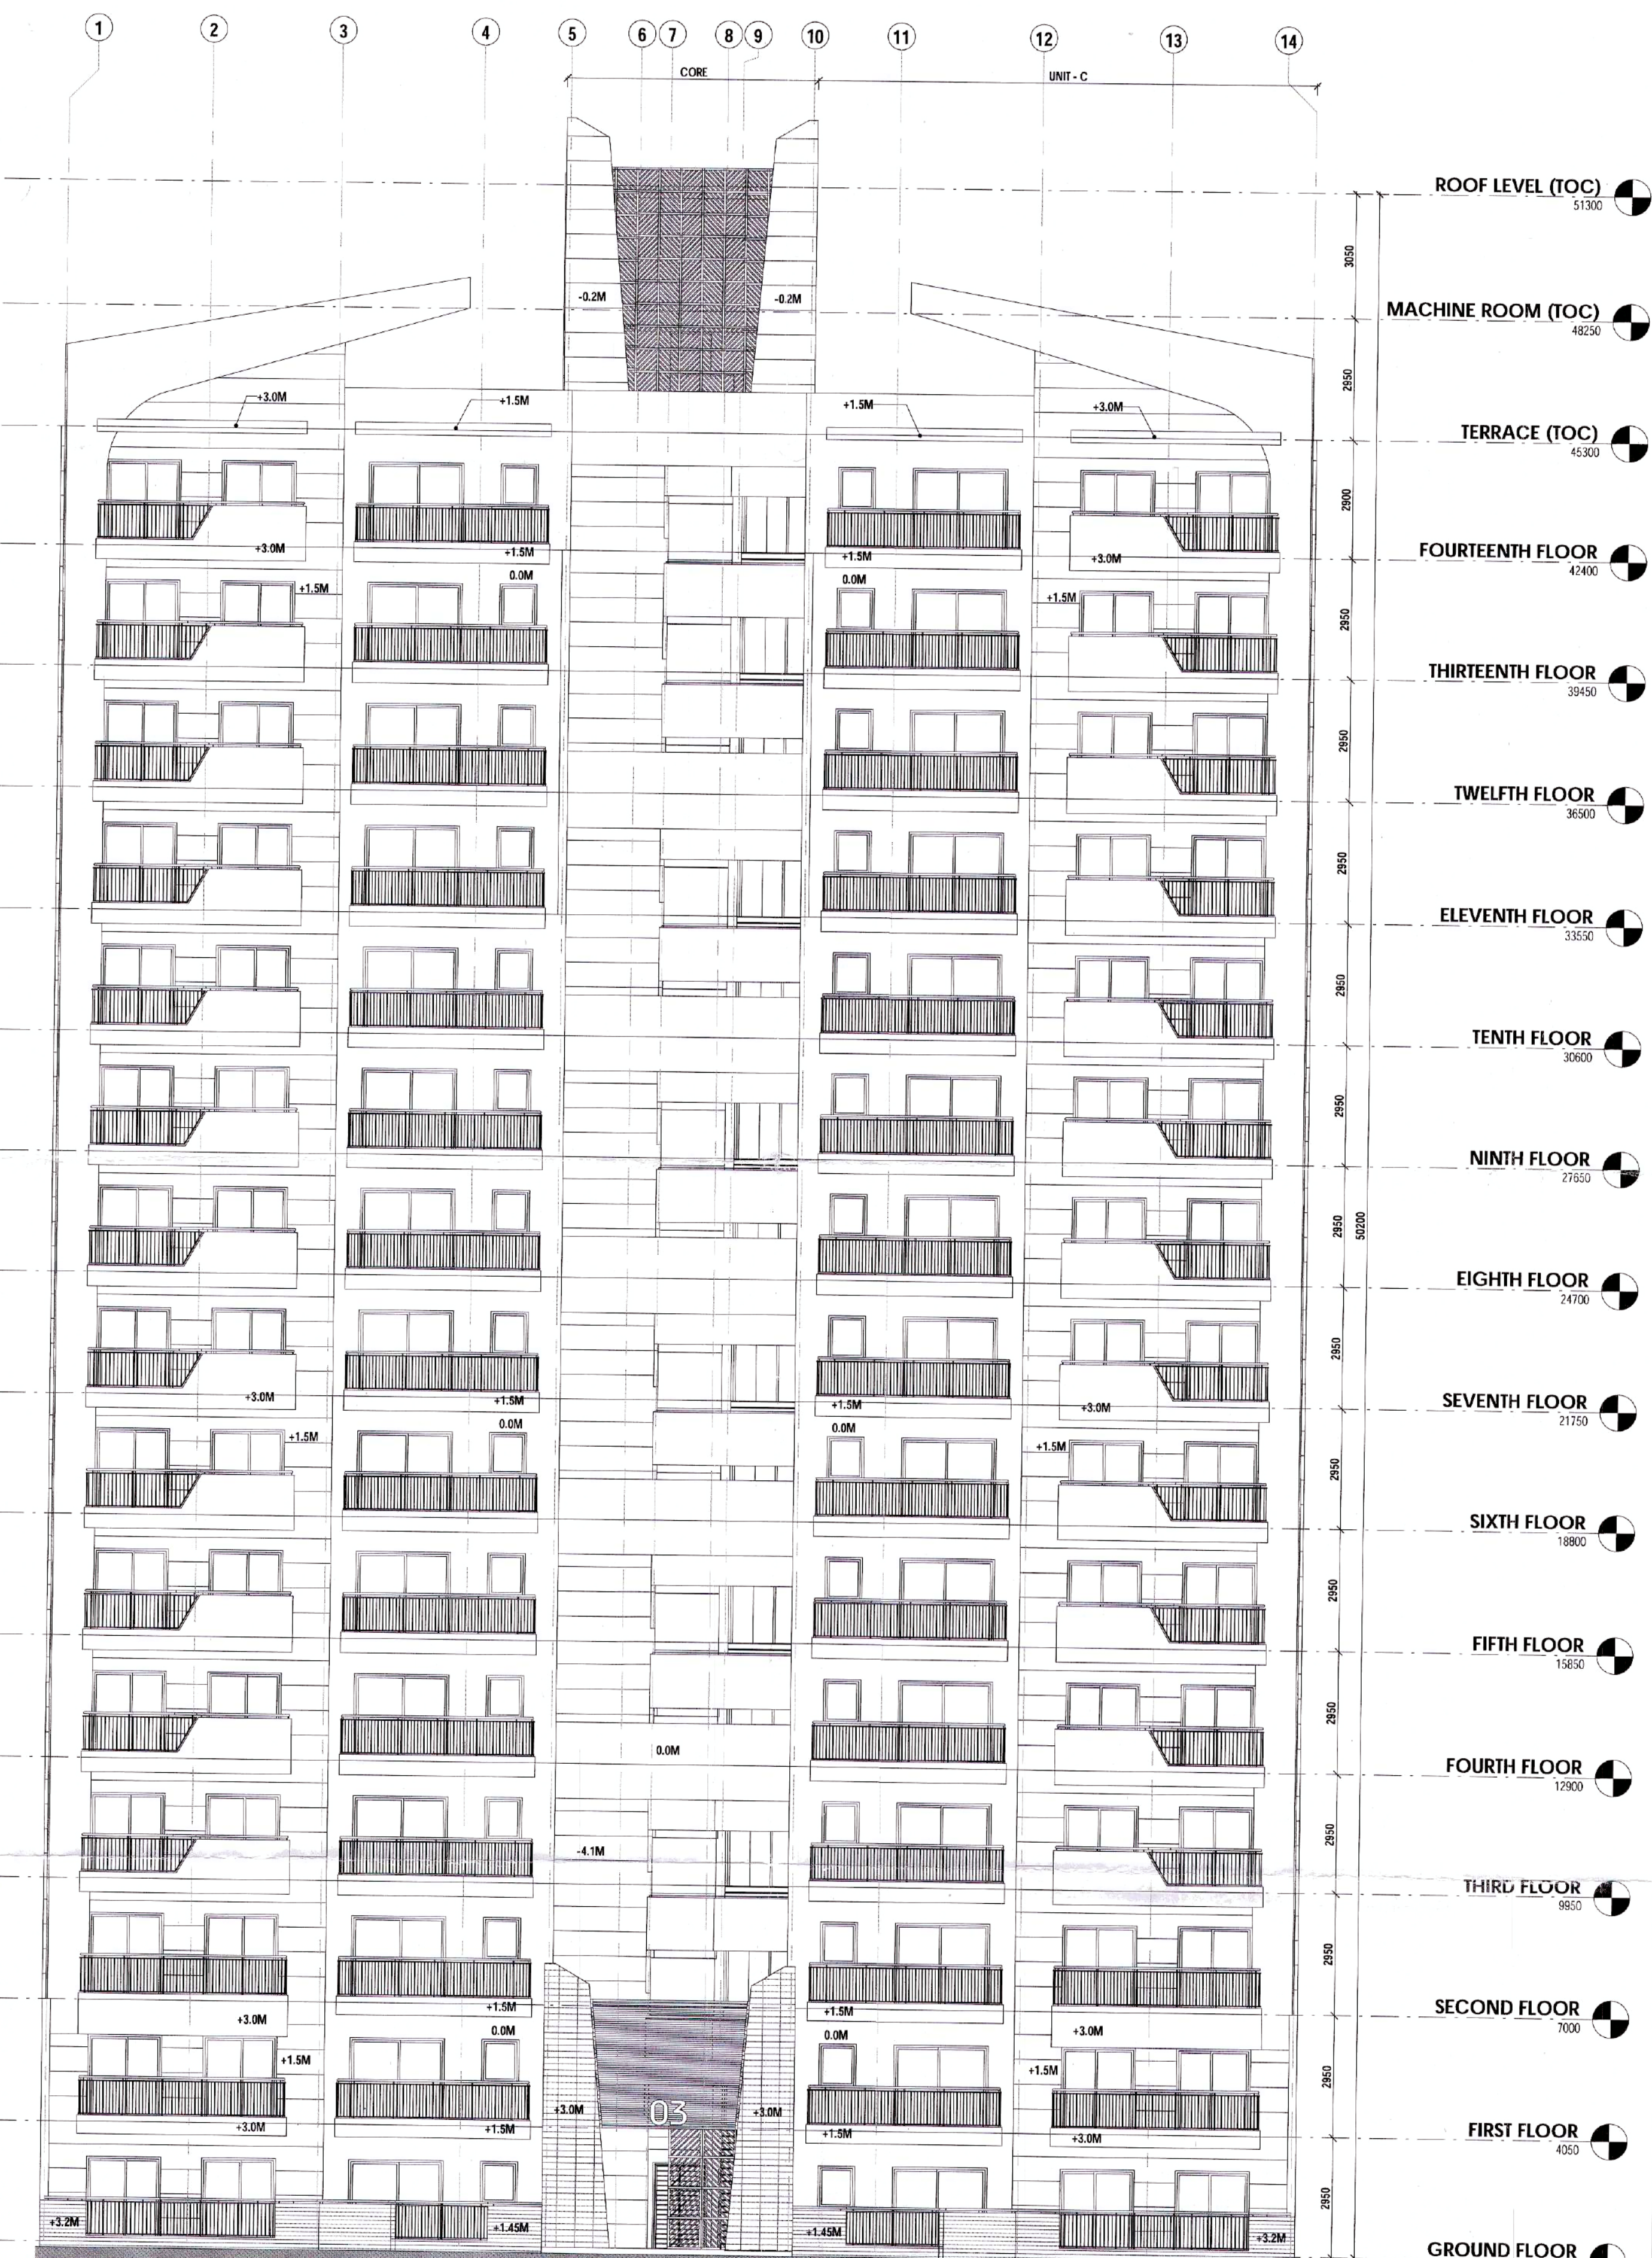

2 South
1:110

JE *Handwritten*
JD *Handwritten*
ATP *Handwritten*
DTP *Handwritten*

Client/Developer
ASHIANA HOUSING LIMITED

Architect
BIAS ARCHITECTURE
Bias+ Architecture
501, Tower No. 24, Commonwealth Games Village, New Delhi 110 052
Phone: +91 11 42052933
Email: projects@biasarchitecture.com

MEP Consultant
V.S. Kulkreja & Associates Pvt. Ltd.
165-A, Gaurahm Nagar
New Delhi 110049

Structure Consultant
Omnet consultants pvt. ltd.
A-45, Sector 04
Noida (UP) 201301
Phone: +91 120 4131184

Electrical Consultant
V.S. Kulkreja & Associates Pvt. Ltd.
165-A, Gaurahm Nagar
New Delhi 110049

Fire Fighting Consultant
V.S. Kulkreja & Associates Pvt. Ltd.
165-A, Gaurahm Nagar
New Delhi 110049

Disclaimer
Drawings and written material appearing herein constitute original and unpublished work of the Architect and may not be duplicated, used or disclosed without written consent of the Architect.

Drawing Status
AS-BUILT DRAWINGS

Architect's Signature
ASHWINI PARASHAR
CA/2003/32346

Client's Signature
ASHIANA HOUSING

Key Plan

Project Name
AS BUILT BUILDING PLAN OF GROUP HOUSING SCHEME MEASURING 13.3375 ACRES (LICENCE NO. 70 OF 2014 DATED 11.06.2014) IN SECTOR-33, SOHNA BEING DEVELOPED BY ASHIANA HOUSING LIMITED (UNDER JOINT DEVELOPMENT AND MARKETING RIGHTS PERMISSION FROM DTCP)

Project Address
Group Housing Project
Sector 33
Sohna, Haryana

Drawing Title
TOWER CC BUILDING ELEVATION - NORTH & SOUTH

Project No. 11.12.R

Scale As indicated

Date DEC 14, 2018

Drawing No
206