



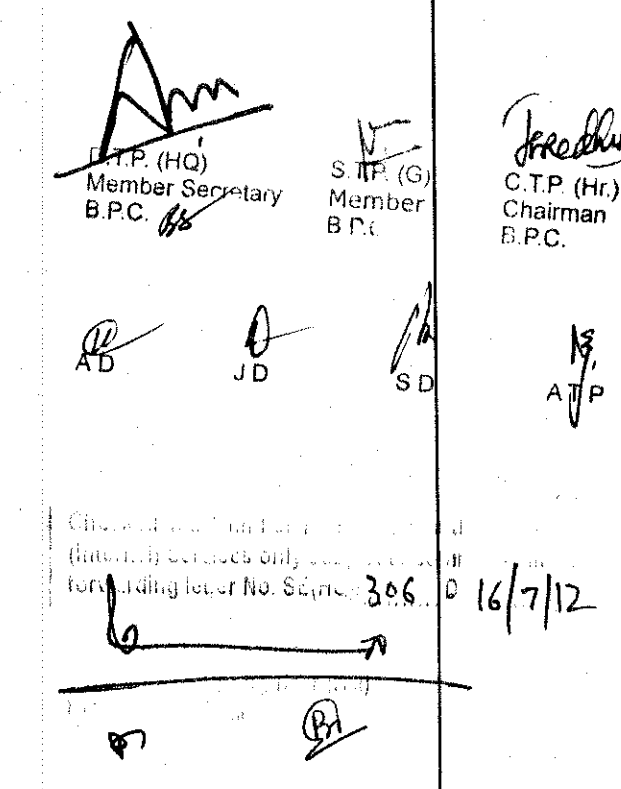

- ① = 100¢ SWP
- ② = 100¢ ~~SWP~~
- ③ = 75¢ ~~SWP~~
- ④ = 100¢ RWP
- ⑤ = DW RISK
- ⑥ = FW RISK
- ⑦ = DW SUPPLY
- ⑧ = FW SUPPLY

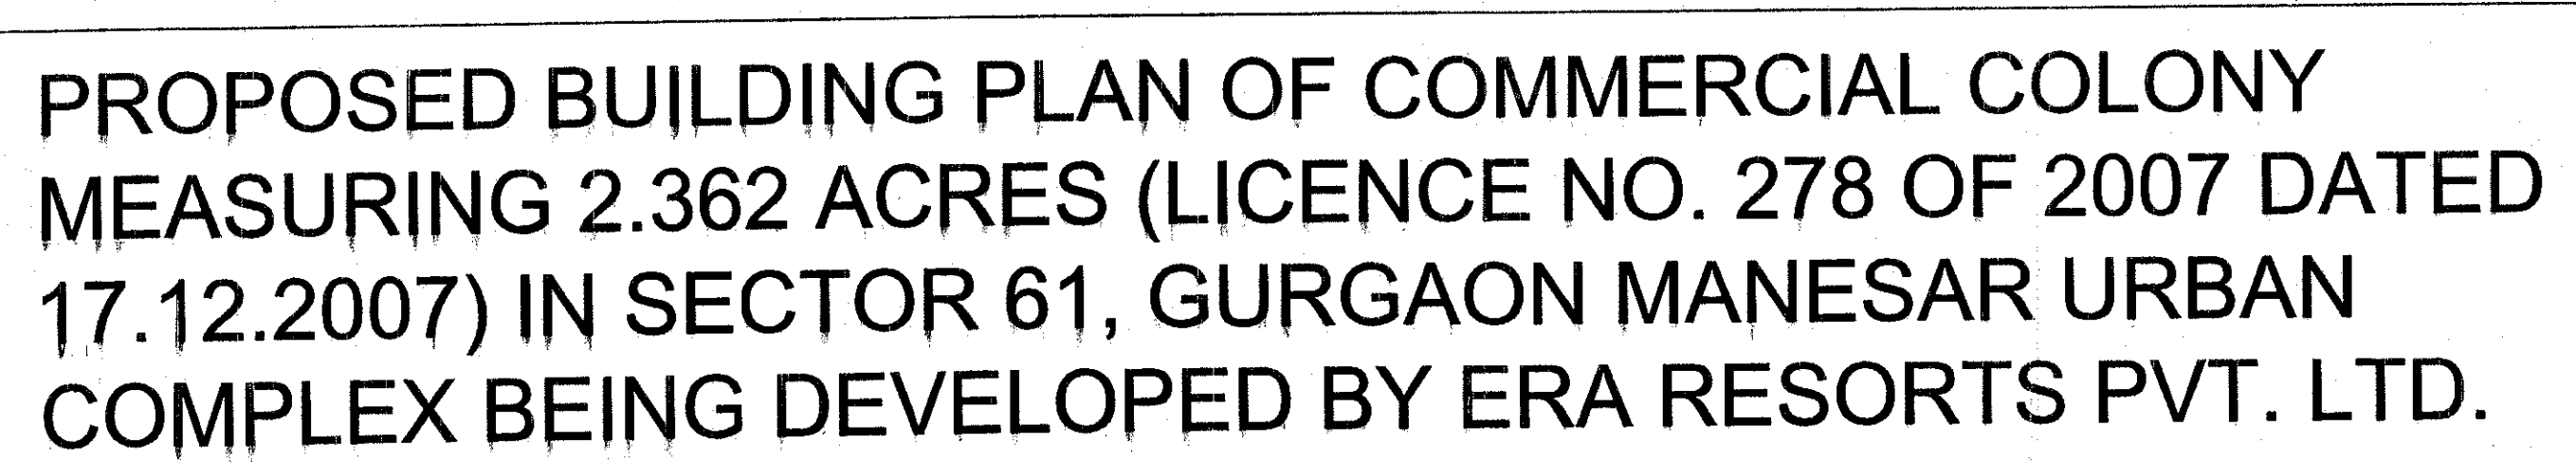

For LRA Resorts Pvt. Ltd.
Amir Tal
 Director

Ar. Amandeep (B.Arch)
CA/2000/26845
116, AKD Tower, Sec-14, Gurgaon
Ph.: 9310352510, 2325565

DRG. TITLE:- SECOND FLOOR PLAN