


~~DDT (T~~  
MEMBE  
BPAC

~~DDT (T~~  
MEMBE  
BPAC



|             |                        |  |
|-------------|------------------------|--|
| SCALE 1:150 |                        |  |
|             | DWG. No.               |  |
|             | SD/AR/M3M-113A/T-B-110 |  |

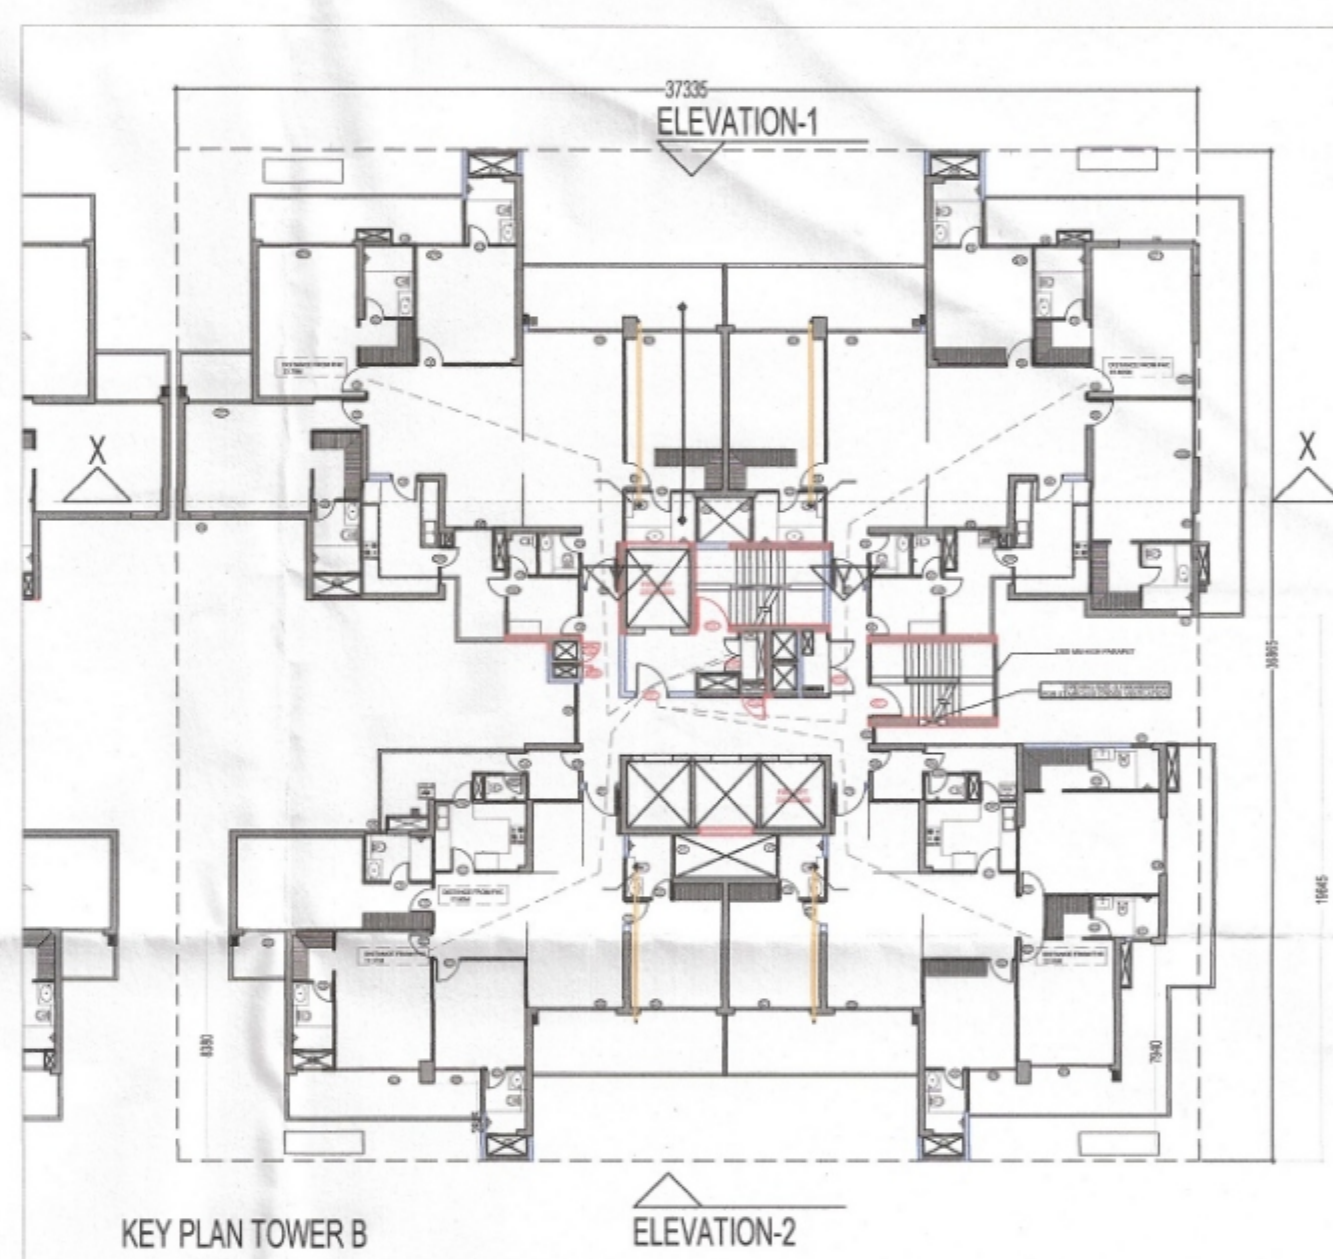