




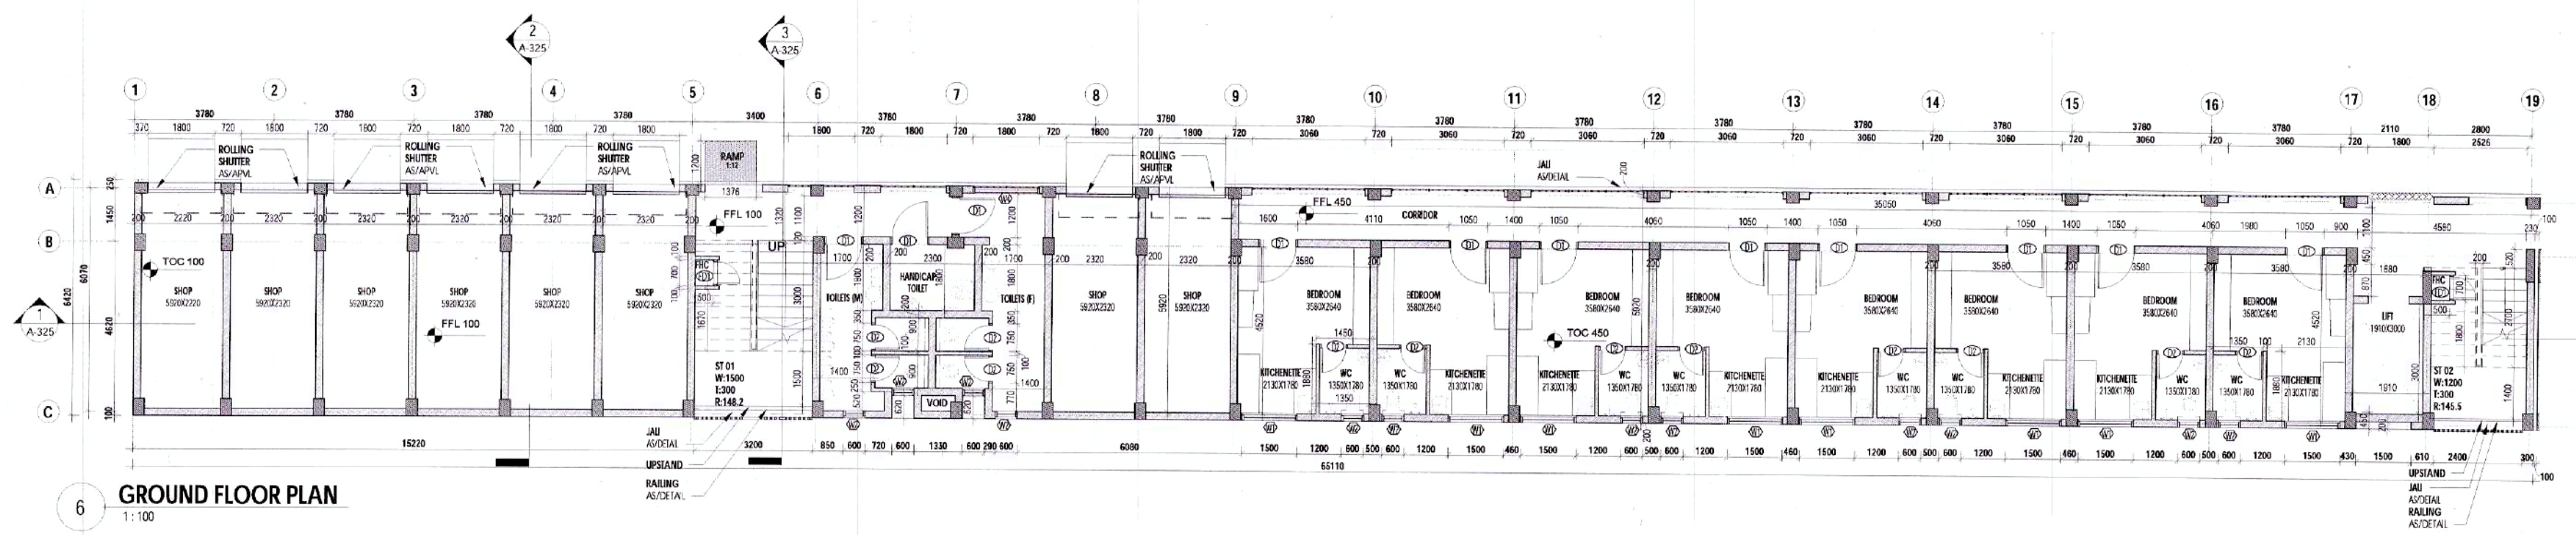


GROUND FLOOR PLAN
1:100

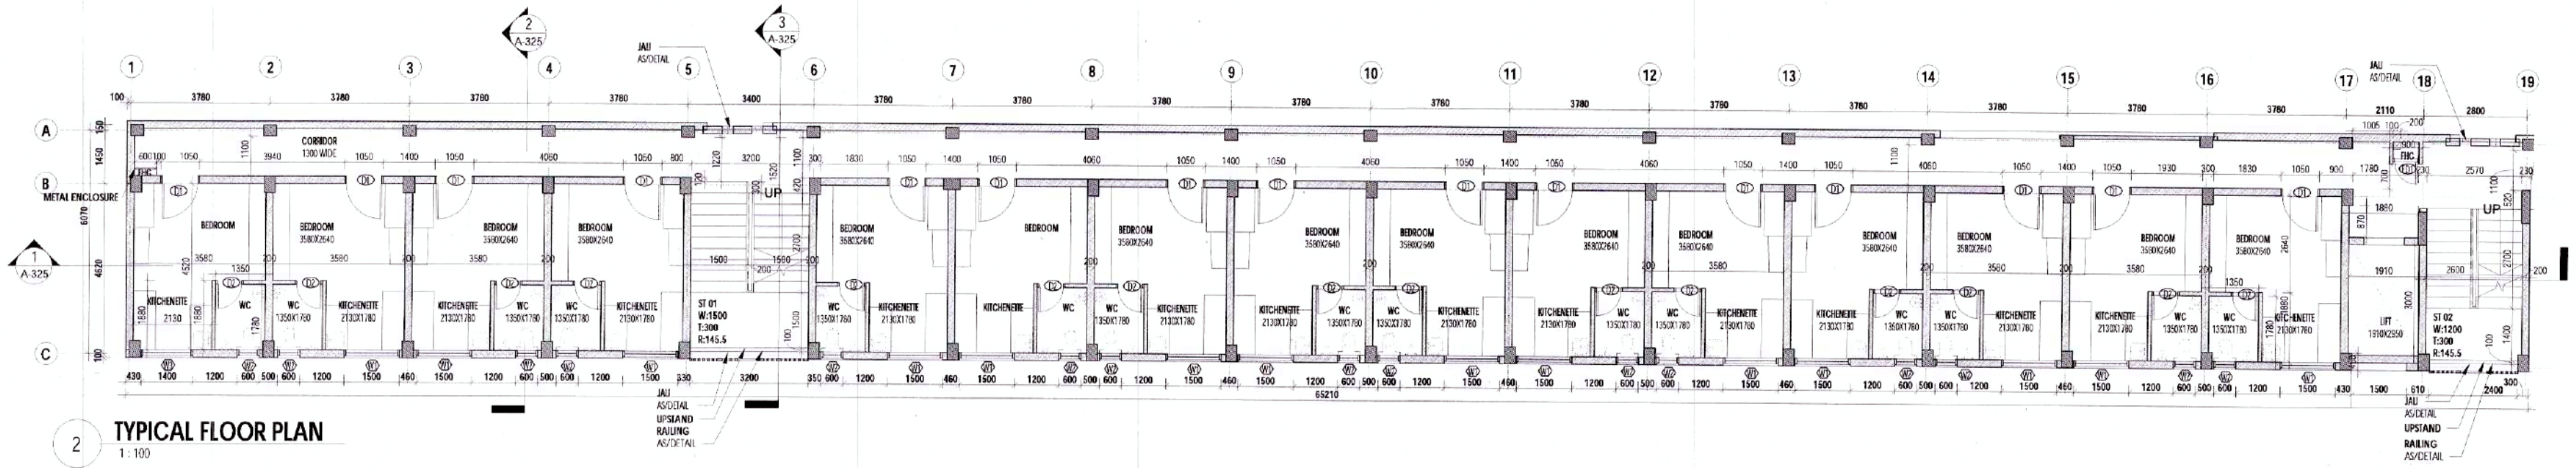


TYPICAL FLOOR PLAN
1:100

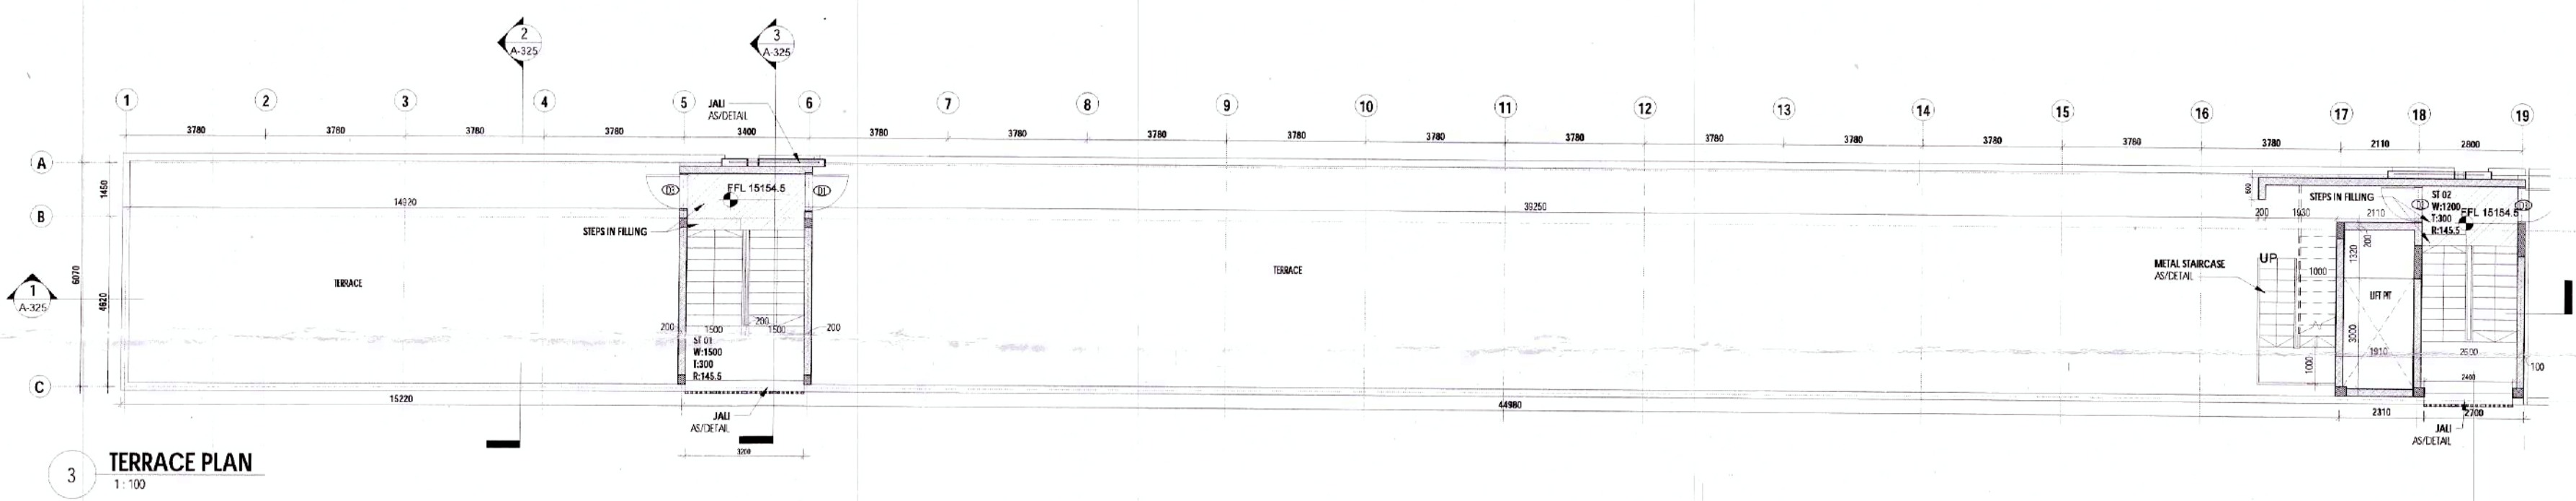


TERRACE PLAN
1:100

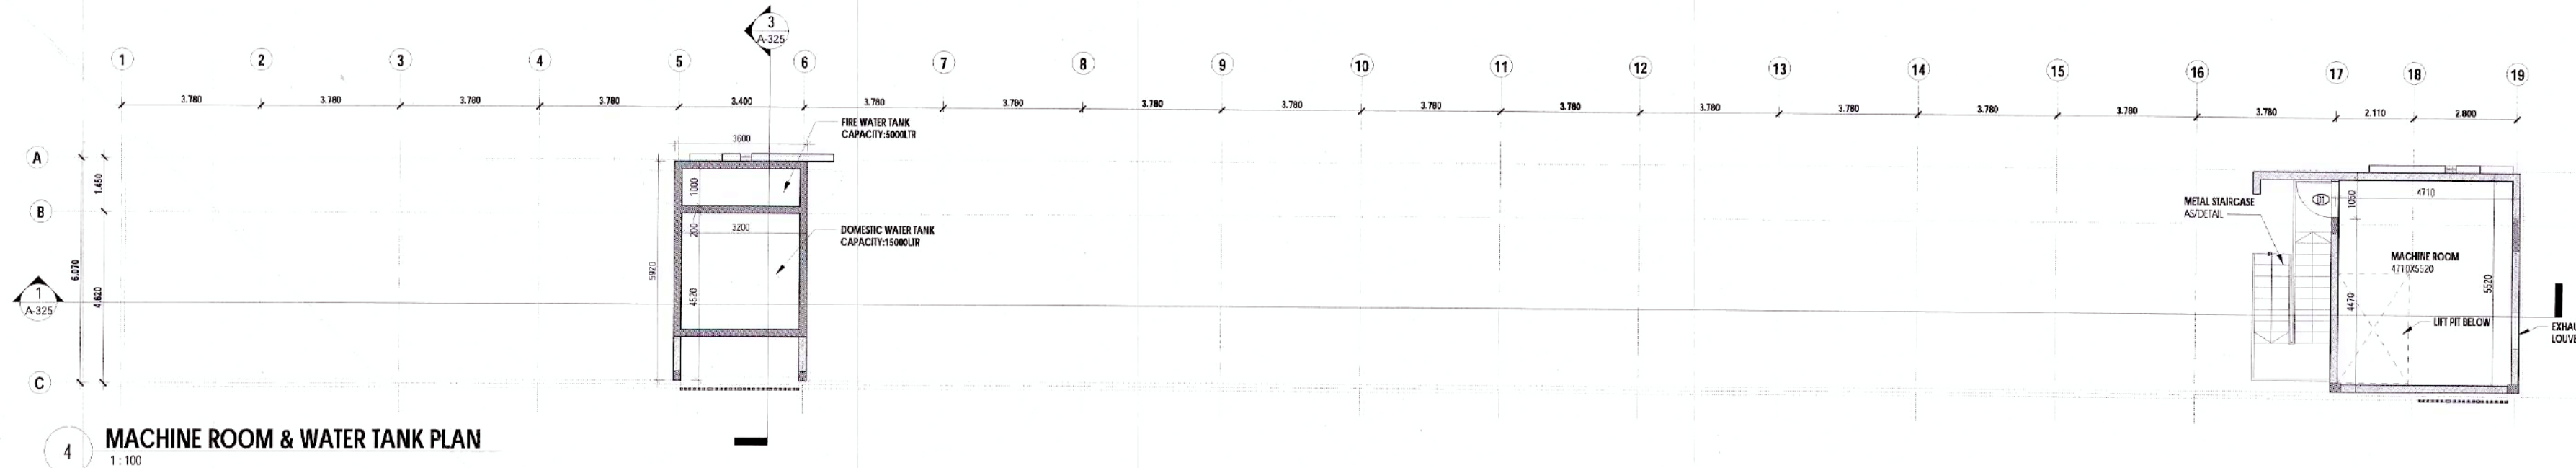


MACHINE ROOM & WATER TANK PLAN
1:100

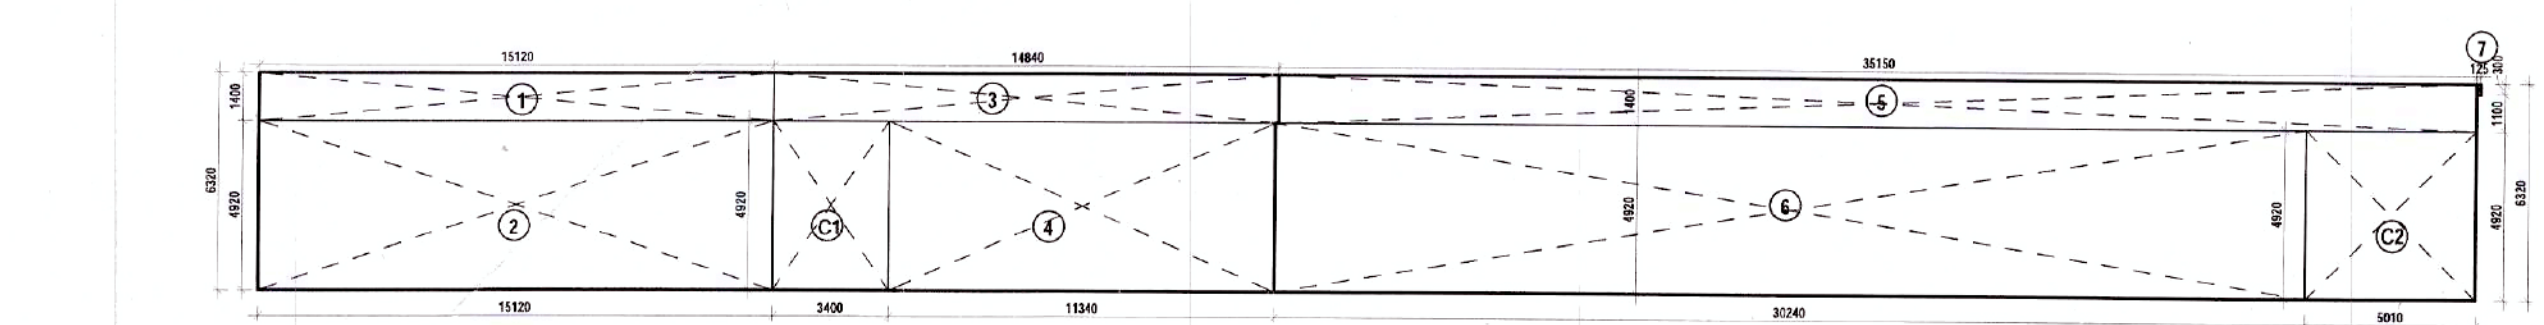

GROUND FLOOR AREA DIAGRAM
1:100

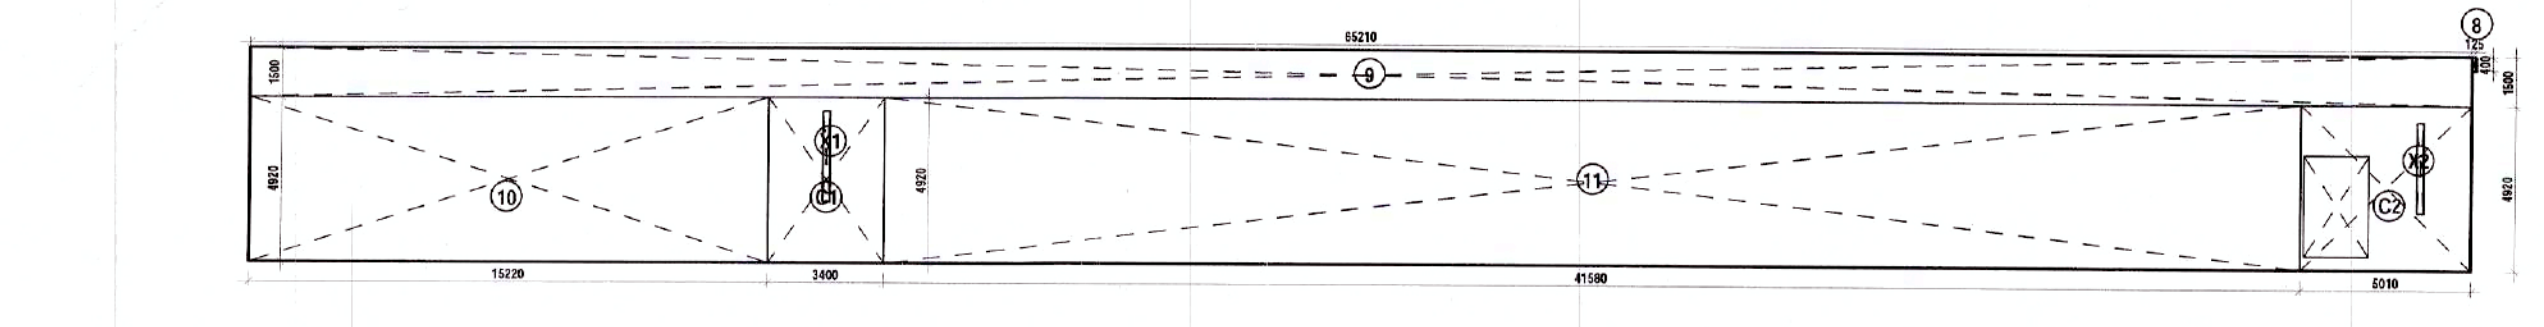

TYPICAL FLOOR AREA DIAGRAM
1:100

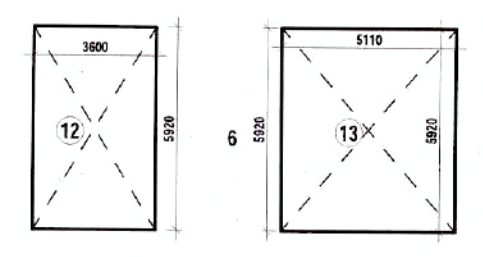

MACHINE ROOM AREA DIAGRAM
1:100

AREA DETAILS OF COMMERCIAL & EWS TOWER GROUND FLOOR									
	LENGTH	BREADTH	NUMBER	AREA (sqm)					
COMMERCIAL									
1	15.12	X	1.40	X	1	=	21.17		
2	15.15	X	4.92	X	1	=	74.54		
3	14.84	X	1.40	X	1	=	20.78		
4	4.92	X	11.34	X	1	=	55.79		
TOTAL AREA - COMMERCIAL							172.27		
EWS									
5	35.15	X	1.4	X	1	=	49.21		
6	30.24	X	4.92	X	1	=	148.78		
7	0.125	X	0.3	X	1	=	0.0375		
TOTAL AREA - EWS GROUND FLOOR							198.0283		
AREA DETAILS OF EWS TOWER - COMMON AREA ON GROUND FLOOR									
	LENGTH	BREADTH	NUMBER	AREA (sqm)					
EWS									
C1	3.4	X	4.92	X	1	=	16.728		
C2	5.01	X	4.92	X	1	=	24.6492		
TOTAL AREA - COMMERCIAL							41.3772		
AREA DETAILS OF EWS TOWER - TYPICAL FLOOR									
	LENGTH	BREADTH	NUMBER	AREA (sqm)					
EWS									
8	0.125	X	0.4	X	1	=	0.05		
9	65.21	X	1.5	X	1	=	97.815		
10	15.22	X	4.92	X	1	=	74.8824		
11	41.58	X	4.92	X	1	=	204.5736		
TOTAL AREA - EWS (I)							377.321		
AREA DETAILS OF EWS TOWER - COMMON AREA ON TYPICAL FLOOR									
	LENGTH	BREADTH	NUMBER	AREA (sqm)					
EWS									
C1	3.4	X	4.92	X	1	=	16.728		
C2	5.01	X	4.92	X	1	=	24.6492		
TOTAL AREA - EWS (II)							41.3772		
DEDUCTION									
X1	0.2	X	2.7	X	2	=	1.08		
X2	1.91	X	3	X	1	=	5.73		
TOTAL AREA							6.81		
AREA DETAILS OF EWS TOWER - MUMTY & MACHINE ROOM									
	LENGTH	BREADTH	NUMBER	AREA (sqm)					
EWS									
12	3.6	X	5.92	X	1	=	21.312		
13	5.1	X	5.92	X	1	=	30.192		
TOTAL AREA							51.504		
TOTAL FAR ON GROUND FLOOR (COMMERCIAL)									
GROUND FLOOR AREA							=	172.27	
TOTAL GROUND COVERAGE (COMMERCIAL)									
GROUND FLOOR AREA							=	172.27	
TOTAL FAR ON GROUND FLOOR (EWS)									
GROUND FLOOR AREA							=	TOTAL	
198.0283							=	239.41	
TOTAL GROUND COVERAGE (EWS)									
GROUND FLOOR AREA							=	TOTAL	
198.028							=	239.41	
TOTAL FAR ON TYPICAL FLOOR (EWS)									
FAR AREA OF EWS - TYPICAL FLOOR							(I)	(II)	(III)
377.321							+	41.3772	-
							+	6.81	-
FAR TYPICAL FLOOR EWS								411.8882	

DOOR SCHEDULE				
TYPE	WIDTH	HEIGHT	UNIT	HEIGHT
D1	1000	2100	1	2100
D2	1000	2100	1	2100
D3	1000	2100	1	2100
D4	1000	2100	1	2100

WINDOW SCHEDULE				
TYPE	WIDTH	HEIGHT	UNIT	HEIGHT
W1	1000	2100	1	2100
W2	1000	2100	1	2100
W3	1000	2100	1	2100
W4	1000	2100	1	2100

Client/Developer
ASHIANA HOUSING, SOHNA

Architect
BIAS

Structural Consultant
GSD&P CONSULTANTS PVT. LTD.

Plumbing Consultant
ASHI HOUSING PVT. LTD.

Electrical Consultant
CHANDRA & ASSOCIATES

Fire Fighting Consultant
FIREPROTECT CONSULTANTS

Disaster Management Consultant
JANAKI RAM, SANGHVI & CO.

Drawing Status
AS BUILT DRAWING

Architect's Signature
[Signature]

Key Plan
ASHWINI PARASHAR
CA/2003/32346

Project Name
PROPOSED BUILDING PLAN OF GROUP HOUSING

Scheme Measuring 13.3375 Acres (Licence No. 20 OF 2014 DATED 11.06.2014 IN SECTION-33, SOHNA BEING DEVELOPED BY UNIVERSE HEIGHTS (INDIA) PVT. LTD.)

Project Address
Group Housing Project
Sector 33
Sohna, Haryana

Drawing Title
EWS PLANS

Project No.
11.12.R

Scale
As Indicated

Date
JAN 07, 2018

Drawing No.
135