


THIS IS A "PROVISIONAL BUILDING PLAN" and is not to be used for any purpose of law or regulation.

TO BE READ WITH THIS OFFICE MEMO NO. DATED :

DOT (P) Member BPAC

J.D. P.A. A.T.P.

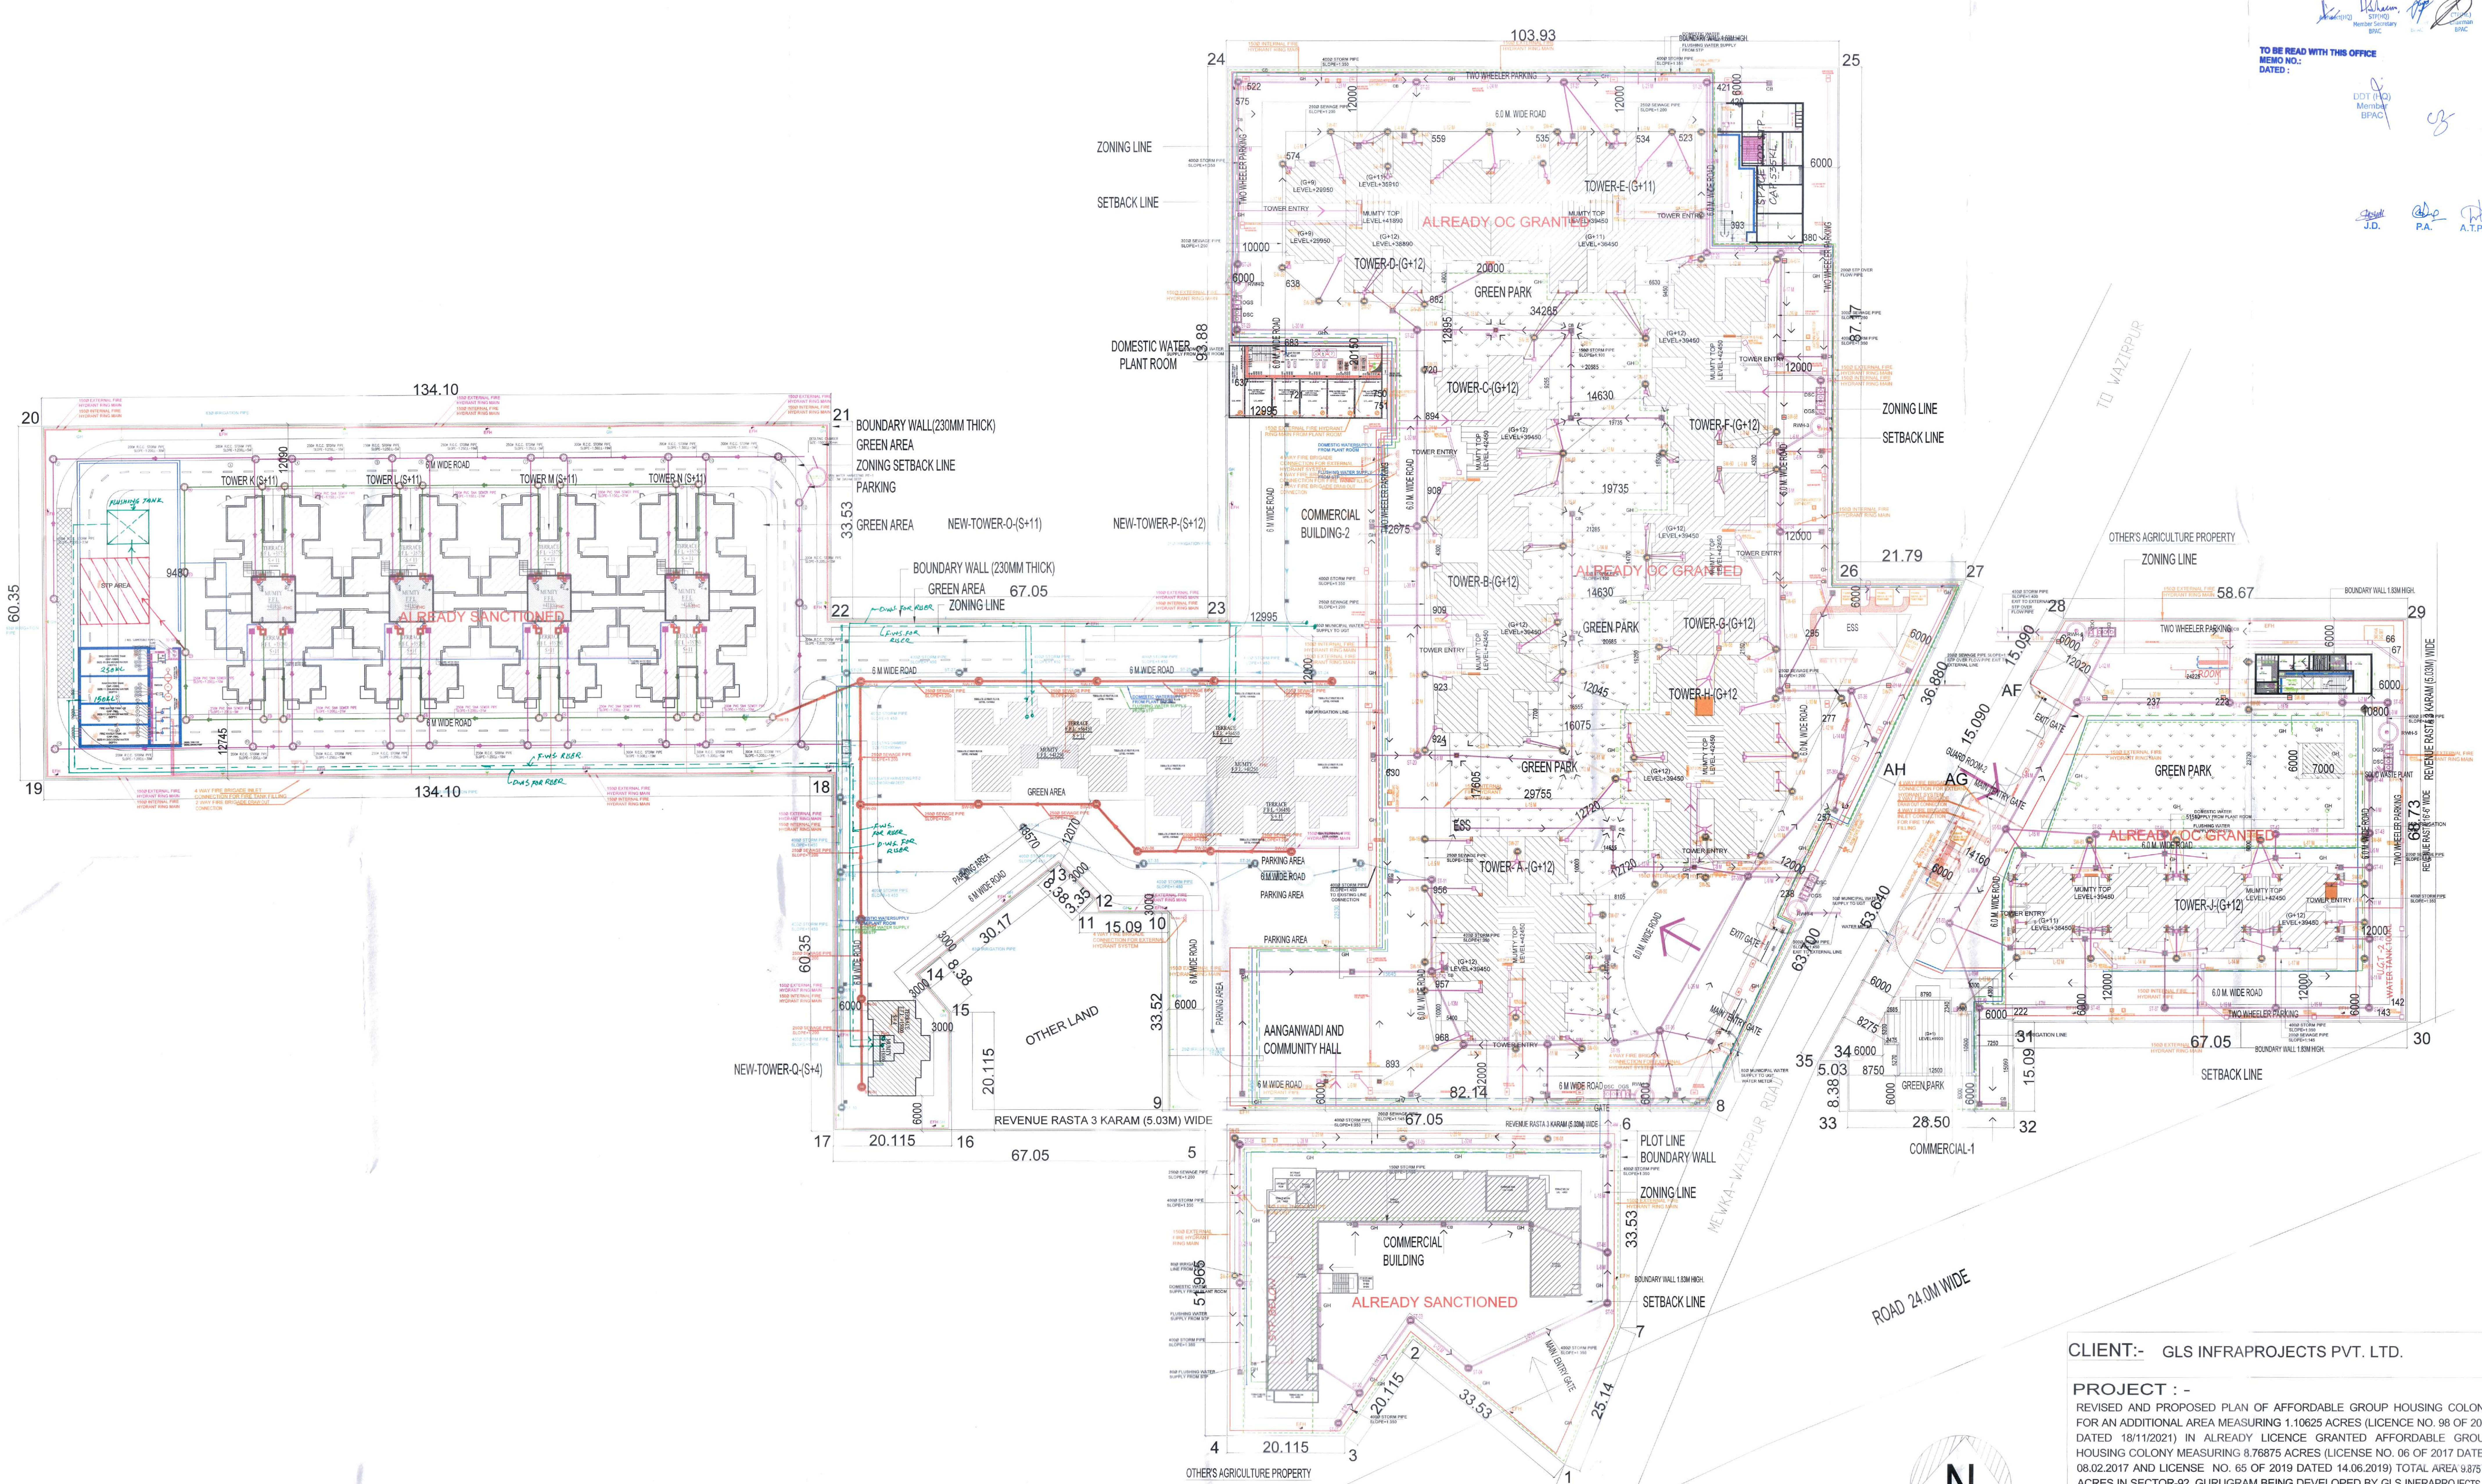

CLIENT:- GLS INFRAPROJECTS PVT. LTD.

PROJECT :-
REVISED AND PROPOSED PLAN OF AFFORDABLE GROUP HOUSING COLONY FOR AN ADDITIONAL AREA MEASURING 1.10625 ACRES (LICENSE NO. 98 OF 2021 DATED 18/11/2021) IN ALREADY LICENSE GRANTED AFFORDABLE GROUP HOUSING COLONY MEASURING 8.76875 ACRES (LICENSE NO. 06 OF 2017 DATED 08.02.2017 AND LICENSE NO. 65 OF 2019 DATED 14.06.2019) TOTAL AREA 9.875 ACRES IN SECTOR-92, GURUGRAM BEING DEVELOPED BY GLS INFRAPROJECTS PVT. LTD.

ARCHITECTS Pinnacle Architects Pvt. Ltd. 838, SECTOR 14, GURGAON HARYANA	SCALE : 1:500 DRAWING NAME SITE PLAN Checked and found ok for Public Health (Internal) Service only, subject to comments in the following sheet(s) 22-12-2021 21/11/21 Additional Civil Engineer (H.O.) H.O.P.P. Panchsala
APPLICANT'S SIGN. 	DRAWING NO. SUB-01- ARCHITECT'S SIGN VIMAL BAJAJ Architect CA/96/19791 938, Sector-14, Gurgaon