


AREA STATEMENT							
S.No.		PERMISSIBLE			PROPOSED		
		%	ACRES	SQM	ACRES	%	SQM
1	NET PLANNED AREA			12.500	50585.705		
2	MAX PERMISSIBLE AREA UNDER PLOTTING	61.00%	7.625	30657.280	6.819	54.55%	27595.331
3	COMMERCIAL AREA	4.00%	0.500	2023.428	0.500	4.00%	2023.167
4	AREA FOR COMMON FACILITIES TO BE HANDLED OVER TO GOVT.	10.00%	1.250	5058.671	1.250	10.00%	5060.212
5	MIN GREEN AREA	7.50%	0.938	3793.926	0.948	7.69%	3840.358
6	NO. OF PLOTS						224
7	OCCUPANCY PER DWELLING PLOT						13.90 PI/PLOT
8	TOTAL POPULATION						3024 PERSONS
9	DENSITY	240-400	PPA				242 PPA

GREEN AREA CALCULATION			
S.No.	Green Number	Sqm	Acres
1	Green-1	278.015	0.069
2	Green-2	139.750	0.035
3	Green-3	160.440	0.040
4	Green-4	2510.677	0.620
5	Green-5	359.776	0.089
6	Green-6	381.701	0.097
	Total	3840.358	0.949

PLOT DETAILS						
Plot Type	Plot No.	Width (m)	Length (m)	Area (Sq.m.)	No.	Total Area (Sq.m.)
A	P1-P15	8.65	15.00	129.75	155	20111.25
	P156-P167	7.00	15.00	105.00	32	3360.00
	P203-P223	7.00	15.00	105.00	21	2205.00
B	P168-P201	7.00	15.00	105.00	4	420.00
	P202	8.35	15.00	125.25	1	125.25
C	P224	9.05	15.00	135.75	1	135.75
	P188-P191	7.00	17.03	119.21	4	476.84
E	P194-P197	7.00	17.03	119.21	4	476.84
	P192-P193	8.35	17.03	142.20	2	284.40
					234	27595.331
					Acres	6.819

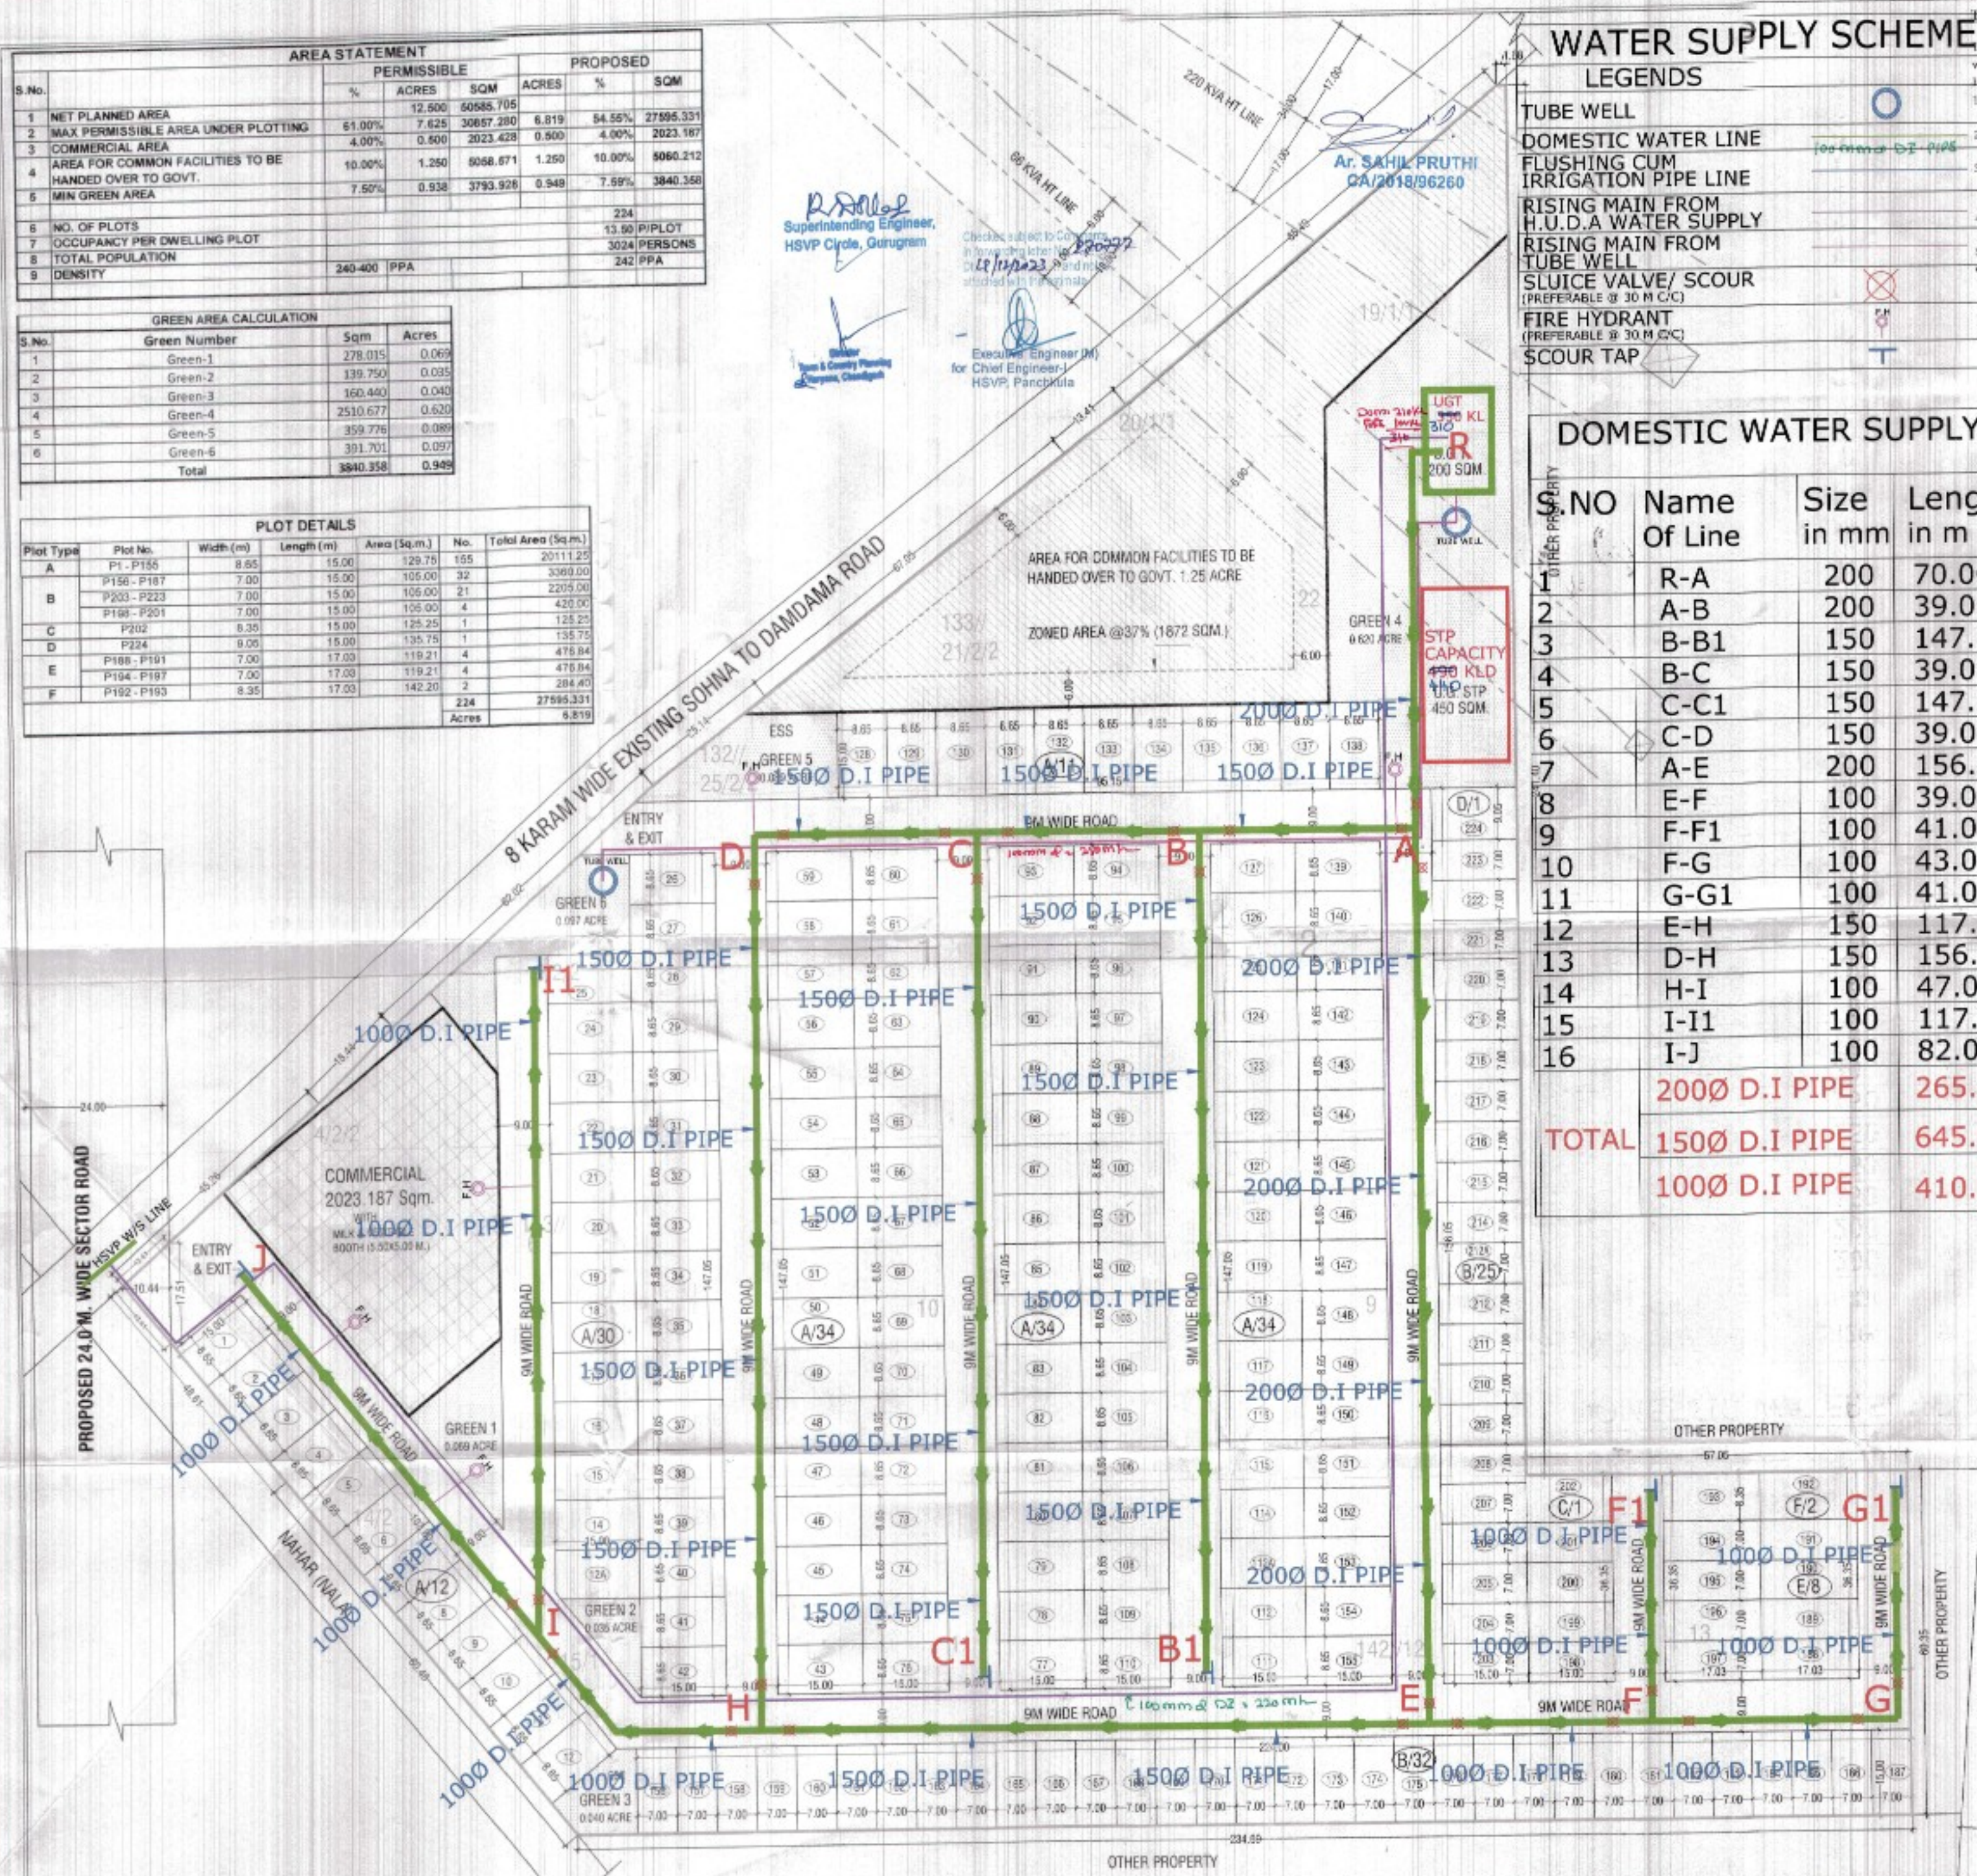

WATER SUPPLY SCHEME

- LEGENDS**
- TUBE WELL
 - DOMESTIC WATER LINE
 - FLUSHING CUM IRRIGATION PIPE LINE
 - RISING MAIN FROM H.U.D.A WATER SUPPLY
 - RISING MAIN FROM TUBE WELL
 - SLUICE VALVE/ SCOUR (PREFERABLE @ 30 M C/C)
 - FIRE HYDRANT (PREFERABLE @ 30 M C/C)
 - SCOUR TAP

- To be read with Licence No. 188 of 2023 dated 15/09/2023
- That this Layout plan for an area measuring 12.50 acres (Drawing No. DG.TCP. 669 dated 15/09/2023) comprised of licence which is issued in respect of Affordable Residential Plotted Colony (Under Deen Dayal Jan Awas Yojna) being developed Lion Infra Developers LLP in Sector 6, Sohna is hereby approved subject to the following conditions:-
- That this Layout Plan shall be read in conjunction with the clauses appearing on the agreement executed under Rule 11 and the standard agreement.
 - That the plotted area of the colony shall not exceed 65% of the net planned area of the colony. The entire area reserved for commercial purposes shall be taken as plotted for calculation of the area under plots.
 - That the demand area plots as per size of all the Residential Plots and Commercial shall be approved from this Department and construction on these plots shall be governed by the Haryana Building Code, 2017 and the Zoning Plan approved by the Director General, Town & Country Planning, Haryana.
 - That for proper planning and integration of services in the area adjacent to the colony, the colonizer shall abide by the directions of the DG, TCP for the modification of layout plans of the colony.
 - That the sewerage lines falling in the colony shall be kept free for circulation/ movement as shown in the layout plan.
 - That the colonizer shall abide by the directions of the DG, TCP, Haryana and accordingly shall make necessary changes in the layout plan for making any adjustment in the alignment of the peripheral roads, internal road circulation or for proper integration of the planning proposals of the adjoining areas.
 - That no property/ plot shall derive access directly from the carriage way of 30 metres or wider sector road if applicable.
 - All green belts provided in the layout plan within the licensed area of the colony shall be developed by the colonizer. All other green belts outside the licensed area shall be developed by the Haryana Urban Development Authority/colonizer on the directions of the Director General, Town and Country planning, Haryana or in accordance with terms and conditions of the agreements of the license.
 - At the time of demarcation plan, if required percentage of organized open space is reduced, the same will be provided by the colonizer in the licensed area.
 - No plot will derive an access from less than 9 metres wide road would mean a minimum clear width of 9 metres between the plots.
 - Any excess area over and above the permissible 6% under commercial use shall be deemed to be open space.
 - The portion of the sector/development plan roads /green belts as provided in the Development Plan if applicable, which form part of the licensed area shall be transferred free of cost to the government on the lines of Section 3(3)(a)(ii) of the Act No.8 of 1975.
 - That the odd size plots are being approved subject to the conditions that these plots should not have a frontage of less than 75% of the standard frontage when demarcated.
 - That you will have no objection to the regularization of the boundaries of the license through give and take with the land that HSPV is finally able to acquire in the interest of planned development and integration of services. The decision of the competent authority shall be binding in this regard.
 - That the rain water harvesting system shall be provided as per Central Ground Water Authority norms/Haryana Govt. notification as applicable.
 - That the colonizer/owner shall use only Light-Emitting Diode lamps (LED) fitting for internal lighting as well as Campus lighting.
 - That the colonizer/owner shall ensure the installation of Solar Power Plant as per provisions of Haryana Solar Power Policy, 2016 issued by Haryana Government Renewable Energy Department vide Notification No. 19/4/2016/Power dated 14/03/2016.
 - That the colonizer/owner shall ensure the installation of Solar Photovoltaic Power Plant as per the provisions of order No. 22/32/2015-Solar dated 21/03/2015 issued by Haryana Government Renewable Energy Department.
 - That the colonizer/owner shall strictly comply with the directions issued vide Notification No. 19/6/2016/SP dated 31/03/2016 issued by Haryana Government Renewable Energy Department for enforcement of the Energy Conservation Building Codes.

DOMESTIC WATER SUPPLY

S.NO	Name Of Line	Size in mm	Length in m
1	R-A	200	70.00
2	A-B	200	39.00
3	B-B1	150	147.00
4	B-C	150	39.00
5	C-C1	150	147.00
6	C-D	150	39.00
7	A-E	200	156.00
8	E-F	100	39.00
9	F-F1	100	41.00
10	F-G	100	43.00
11	G-G1	100	41.00
12	E-H	150	117.00
13	D-H	150	156.00
14	H-I	100	47.00
15	I-I1	100	117.00
16	I-J	100	82.00
TOTAL		2000 D.I PIPE	265.00
		1500 D.I PIPE	645.00
		1000 D.I PIPE	410.00


- COMMERCIAL BLOCK
- LAND TO BE HANDLED OVER TO GOVERNMENT FOR AMENITIES
- GREEN AREA
- STP (450 SQMT.)
- UGT (200 SQMT.)
- M.B. MILK & VEGETABLE BOOTH (5.50X5.00 M.)

CLIENT / OWNER

M/S LION INFRADEVELOPERS LLP.

PROJECT

Layout plan of Affordable Residential Plotted Colony (Under Deen Dayal Jan Awas Yojna) over an area measuring 12.50 acres.

(LIC No. LC-5105/06 (D5/2023/2191) dated 04.07.2023)

