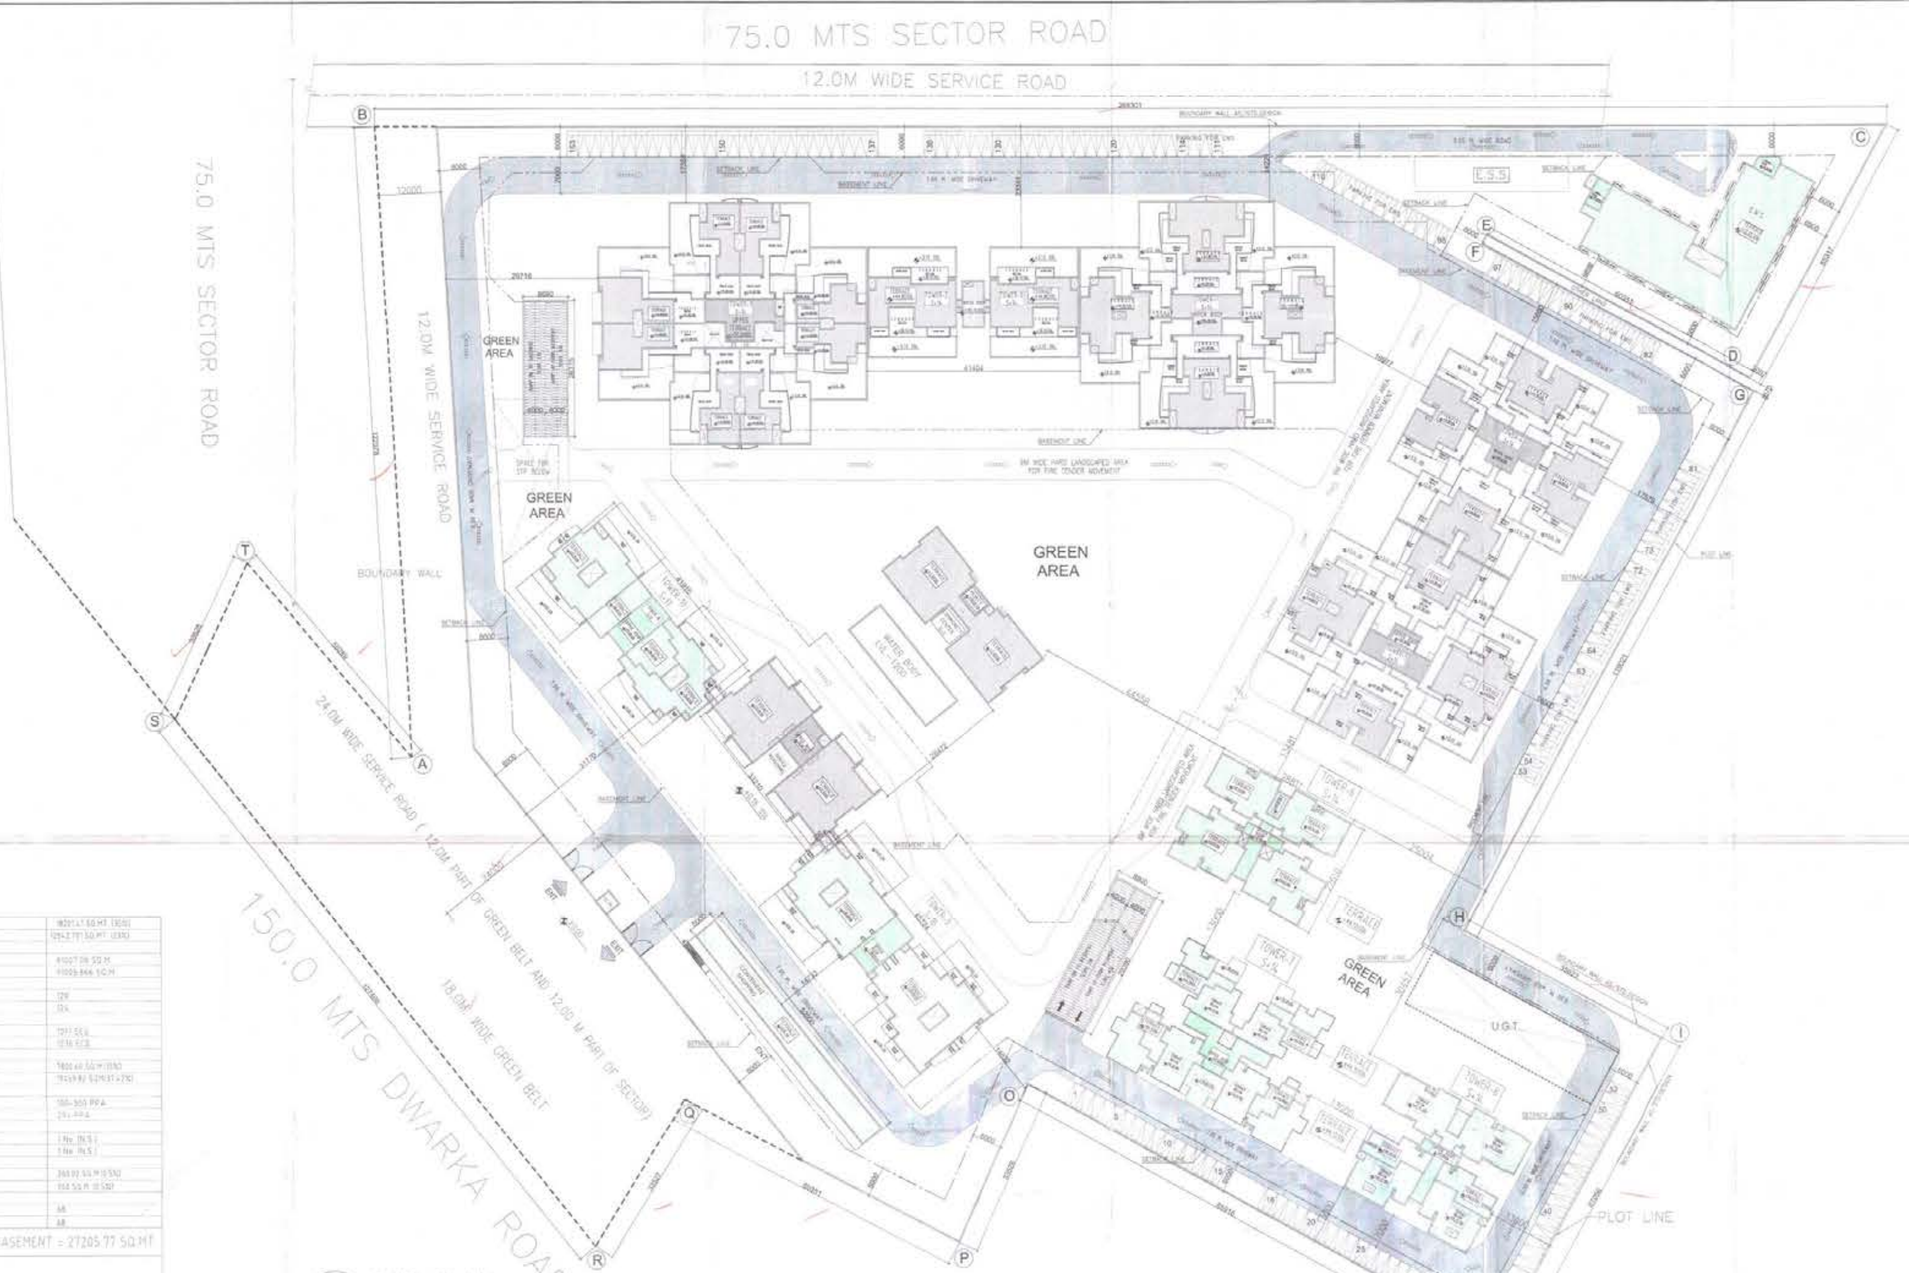

A	PERMISSIBLE GROUND COVERAGE	18201.41 SQ.MT (33%)
	PROPOSED GROUND COVERAGE	12842.701 SQ.MT (23%)
B	PERMISSIBLE F.A.R	91007.08 SQ.M
	PROPOSED F.A.R	91005.666 SQ.M
C	REQUIRED E.W.S UNIT - 15%(88 EE)	129
	PROPOSED E.W.S UNIT	104
D	MINIMUM REQUIRED CAR PARKING	1771 ECS
	PROPOSED CAR PARKING	1816 ECS
E	REQUIRED ORGANIZED GREEN SPACE	7800.60 SQ.M (15%)
	PROPOSED ORGANIZED GREEN SPACE	7919.98 SQ.M (15.2%)
F	PERMISSIBLE DENSITY	300-350 PPA
	PROPOSED DENSITY	291 PPA
G	REQUIRED COMMUNITY SITE	1 No. (N.S)
	PROPOSED COMMUNITY SITE	1 No. (N.S)
H	PERMISSIBLE COMMERCIAL AREA	2600.93 SQ.M (0.5%)
	PROPOSED COMMERCIAL AREA	1512.50 SQ.M (0.5%)
J	REQUIRED SERVICE PERSONALS	68
	PROPOSED SERVICE PERSONALS	68

REVISED COVERED AREA IN BASEMENT = 27205.77 SQ.MT

DENSITY CALCULATIONS

TOTAL No. OF MAIN DWELLING UNITS = 1408 Nos.
POPULATION = (1408) x 3.500 PERSONS
E.W.S = 104 Nos.
POPULATION x(104) = 248 PERSONS
SERVICE PERSONALS = 68 Nos.
POPULATION = (68)2 = 136 PERSONS
TOTAL POPULATION = 5000+248+136 = 5384 PERSONS
DENSITY = 5384/13.000 = 414.46 SAY 414 PERSONS PER ACRE

AREA STATEMENT	ACRES	SQ.MT.	SQ.FT.
PLOT AREA	13.3200	53,904.04	5,80,223.11
F.A.R AVAILABLE ON PLOT AS/ZONING	12.8509	52,004.04	5,59,771.48
PERMISSIBLE F.A.R.	1.75	91,007.08	9,79,600.21
GROUND COVERAGE	0.36	18,201.41	1,96,020.02
ACHIEVED GROUND COVERAGE	0.23	12,842.701	1,38,009.63
ACHIEVED F.A.R.	100.00	91,005.666	9,79,584.99
F.A.R. in Hand		1.414	15.22

TOWER TYPE	NO. OF BLOCK	GROUND COVERAGE SQ.MT	STILT AREA SQ.MT.	F.A.R. ON STILT FLOOR SQ.MT.	COVERED AREA ON TYPICAL FLOOR SQ.MT.	NO. OF TYPICAL FLOOR	COVERED AREA ON 11th FLOOR SQ.MT.	COVERED AREA ON 14th FLOOR SQ.MT.	COVERED AREA ON LOWER PENTHOUSE SQ.MT.	COVERED AREA ON UPPER PENTHOUSE SQ.MT.	NO. OF FLOORS	TOTAL COVERED AREA F.A.R. SQ.MT.	NO. OF DWELLING UNIT			REMARKS
													MAIN UNIT	SERVICE UNIT	E.W.S	
TOWER-1	1	1646.72	1557.52	89.2	937.73	12			679.44	446.31	S+14	12867.710	104			ALREADY SANCTIONED
TOWER-2	1	790.32	745.94	44.38	371.85	12			320.31	214.71	S+14	5041.900	28			ALREADY SANCTIONED
TOWER-3	1	2053.03	1962.4	90.63	1058.99	12			881.03	511.67	S+14	14291.210	104			ALREADY SANCTIONED
TOWER-4	1	1198.44	1107.35	91.09	709.25	12			670.16	358.28	S+14	9630.500	104			ALREADY SANCTIONED
TOWER-5	1	1469.24	1377.39	91.85	853.06	12			807.12	428.21	S+14	11860.900	104			ALREADY SANCTIONED
COMMUNITY CENTER	1	328.32			328.32						G+1	656.64				ALREADY SANCTIONED
SERVICE PERSONALS	1	435.11	389.59	45.52	426.11	8					S+8	3494.40		64		ALREADY SANCTIONED
TOWER-6	1	492.989	386.61	66.289	432.75	13		350.977			S+14	5942.988	64			REVISED
TOWER-7	1	684.784	573.369	81.415	642.784	4			572.371	110.659	S+14	8116.701	52			REVISED
					596.815	8										REVISED
TOWER-8	1	486.318	396.488	89.83	456.018	13		144.965			S+14	6143.029	52			REVISED
TOWER-9	1	532.87	474.29	58.61	550.21	10					S+10	5560.71	40			REVISED
TOWER-10	1	872.38	826.57	45.81	464.01	10	129.69				S+11	4815.6	40	4		REVISED
EWS	1	715.32			715.32	3					G+3	2861.28			124	REVISED
COMMERCIAL	1	260.00										260.00				REVISED
SHAFT WALL AREA												2.40				REVISED

SHAFT WALL AREA = 2.40x4.25m = 248.93 MT

PARKING CALCULATIONS

REQUIRED No. OF CAR PARKING = 1408 NOS. TOTAL No. OF MAIN DWELLING UNITS = 1408 Nos. = 1408 Nos.
REQUIRED COVERED CAR PARKING = 75% OF TOTAL No. OF CAR PARKING = 765 Nos.
TOTAL No. OF COVERED CAR PARKING PROVIDED -

PARKING PROVIDED
SURFACE OPEN PARKING = 16 ECS
BASEMENT PARKING = 1781 ECS

STILT -
TOWER-1 = 52 NOS.
TOWER-2 = 25 NOS.
TOWER-3 = 65 NOS.
TOWER-4 = 37 NOS.
TOWER-5 = 44 NOS.
TOWER-6 = 18 NOS.
TOWER-7 = 14 NOS.
TOWER-8 = 13 NOS.
TOWER-9 = 29 NOS.
TOWER-10 = 28 NOS.
SERVICE PERSONALS 3 NOS.
TOTAL = 340 NOS.

5% PARKING OF TOTAL PARKING PROVIDED WILL BE RESERVED FOR E.W.S
i.e. 5%x35 = 17.80 SAY 42 ECS
PARKING NO. FOR E.W.S = 52 ECS

TOTAL ECS PROVIDED
TOTAL No. OF COVERED PARKING = BASEMENT + STILT
= 1781+340 = 1975 ECS

STRUCTURAL STABILITY CERTIFICATE

I, CERTIFIED THAT THE BUILDING PLANS FOR APPROVAL SATISFY THE SAFETY REQUIREMENTS AS STIPULATED UNDER CLAUSE 36 OF BUILDING BYE-LAWS, 1983 AND THE INFORMATION GIVEN THEREIN IS FACTUALLY CORRECT TO THE BEST OF OUR KNOWLEDGE AND UNDERSTANDING
II. IT IS ALSO CERTIFIED THAT THE STRUCTURAL DESIGN INCLUDING SAFETY FROM NATURAL HAZARDS BASED ON SOIL CONDITION HAS BEEN DULY INCORPORATED IN THE DESIGN OF BUILDING AND THESE PROVISIONS SHALL BE ADHERED TO DURING THE CONSTRUCTION

NOTE FOR BASEMENT

THE WALLS & FLOOR OF THE BASEMENT SHALL BE WATER TIGHT & SO DESIGNED THAT THE EFFECT OF THE SURROUNDING SOIL & POSTURE IT MAY ARE TAKEN IN TO ACCOUNT & DESIGN & ADEQUATE SWIM PROOFING TREATMENT BE GIVEN

NOTE FOR WATER HARVESTING

1. CERTIFIED THAT THE BUILDING PLANS SUBMITTED FOR APPROVAL SATISFY THE WATER HARVESTING REQUIREMENTS AS WELL AS MINIMUM ANTICIPATED DISCHARGE OF WASTE WATER AS STIPULATED UNDER CLAUSE 224(1)(a-L) AND THE INFORMATION GIVEN THEREIN IS FACTUALLY CORRECT TO THE BEST OF OUR KNOWLEDGE AND UNDERSTANDING
2. WASTE WATER RECYCLING SYSTEM SHALL BE INCORPORATED AT SITE THE RECYCLED WATER SHALL BE USED FOR HORTICULTURE PURPOSE

CERTIFICATE

1.THE NALAS IN THE CONSTRUCTION WILL BE REMOVED WEEKLY BASE IF THE SAME IS NOT DONE IN THE CASE THE LOCAL BODY SHALL REMOVE THE NALAS AND COST SHALL BE BORNE BY THE OWNER OF PLOT
2. DURING CONSTRUCTION IT IS MANDATORY ON THE PART OF THE OWNER TO PROPERLY SCREEN THE CONSTRUCTION SITE OF MAIN ROAD BY MEANS OF CREATING A SCREEN WALL NOT LESS THAN 8'-0" IN HEIGHT FROM GROUND LEVEL WHICH IS TO BE PAINTED TO AVOID IN PLEASANT LOOK FROM ROAD SIDE IN ADDITION TO THIS A NET OR SAME OTHER PROTECTIVE MATERIAL SHALL BE HOISTED AT THE FACADES OF THE BUILDING TO ENSURE THAT ANY FALLING MATERIAL REMAINS WITHIN THE PROTECTED AREA
3. NOISE RELATED ACTIVITIES WILL NOT BE TAKEN UP AND CONSTRUCTION AT NIGHT AFTER 10 pm

NOTE:-
THE LIFT AND PLUMBING WORK SHALL BE AS PER I.S.I. STANDARD

FIRE SAFETY MEASURES
1. THE OWNER WILL ENSURE THE PROVISION OF PROPER FIRE SAFETY MEASURES IN THE MULTI STOREY BUILDINGS CONFORMING TO THE PROVISIONS OF RULES FRAMED AND THE SAME SHALL BE GET CERTIFIED FROM THE COMPETENT AUTHORITY
ELECTRIC SUB STATION / GENERATOR ROOM IF PROVIDED SHALL BE ON SOLID GROUND NEAR 25KVA CENTRAL PANEL ON GROUND PLINTH OR IN UPPER BASEMENT AND IT SHALL BE LOCATED ON OUTER PERIPHERY OF THE BUILDING, THE SAME SHALL BE GET APPROVED FROM THE COMPETENT AUTHORITY

SOLAR WATER HEATING SYSTEM

THE PROVISION OF SOLAR WATER HEATING SYSTEM SHALL BE AS PER NORMS SPECIFIED BY MNRE & AND SHALL BE MADE OPERATIONAL IN EACH BUILDING BLOCK BEFORE APPLYING FOR AN OCCUPATION CERTIFICATE

RAIN WATER HARVESTING SYSTEM

THE RAIN WATER HARVESTING SYSTEM SHALL BE PROVIDED AS PER CENTRAL GROUND WATER AUTHORITY NORMS/UNIFORM DRAFT NOTIFICATION AS APPLICABLE

NOTE:
ALL TOILETS ARE MECHANICALLY LIT AND VENTILATED

NOTES:
1. GATE AND BOUNDARY WALL AS STD. DESIGN
2. EXHAUST FAN TO BE PROVIDED IN ALL KITCHENS & TOILETS
3. SPRINKLERS TO BE PROVIDED IN THE PREMISES AS PER NBC NORMS
4. 100% POWER BACKUP FOR RUNNING THE EMERGENCY SERVICES
5. TOILETS & POWDER ROOMS ARE MECHANICALLY VENTILATED AND LIT
6. BASEMENT ARE MECHANICALLY VENTILATED AND LIT.
7. SERVICE AREA & LIFT ARE 100% POWER BACKUP

REVISED

ALREADY SANCTIONED

For Shivnandan Buildtech Pvt. Ltd.
Director

Executive Engineer
HSVP Division Ltd V
Gurugram-V

Checked and Detailed as for Public Health (Sewage) Service fully subject to comments in as forwarding letter No. 7000/PH-II/2011/

Ichinen Architects Private Limited
A-9 SHRISHTI ENCLAVE, NEW DELHI
Asst. Chief Engineer
HSVP Gurugram

OWNERS SIGN	ARCHITECTS SIGN
Director	ARCHITECT RAJESH JAIN CA/92/13024

Project:
REVISED & PROPOSED BUILDING PLANS OF GROUP HOUSING SCHEME AREA MEASURING 13.32 ACRE (LICENCE NO.70 OF 2011 DATED 22/07/2011 & LICENCE NO.83 OF 2012 DATED 27.08.2012) IN SECTOR-99 GURUGRAM MANESAR URBAN COMPLEX

Owner: M/S SHIVNANDAN BUILDTECH PVT. LTD.

SCALE:	AS SHOWN
DATE:	27-JUNE-2013
DRAWN:	SUBMISSION DRAWING
CHECKED:	
APPROVED:	
DRG. NO. 01	REV.-R0

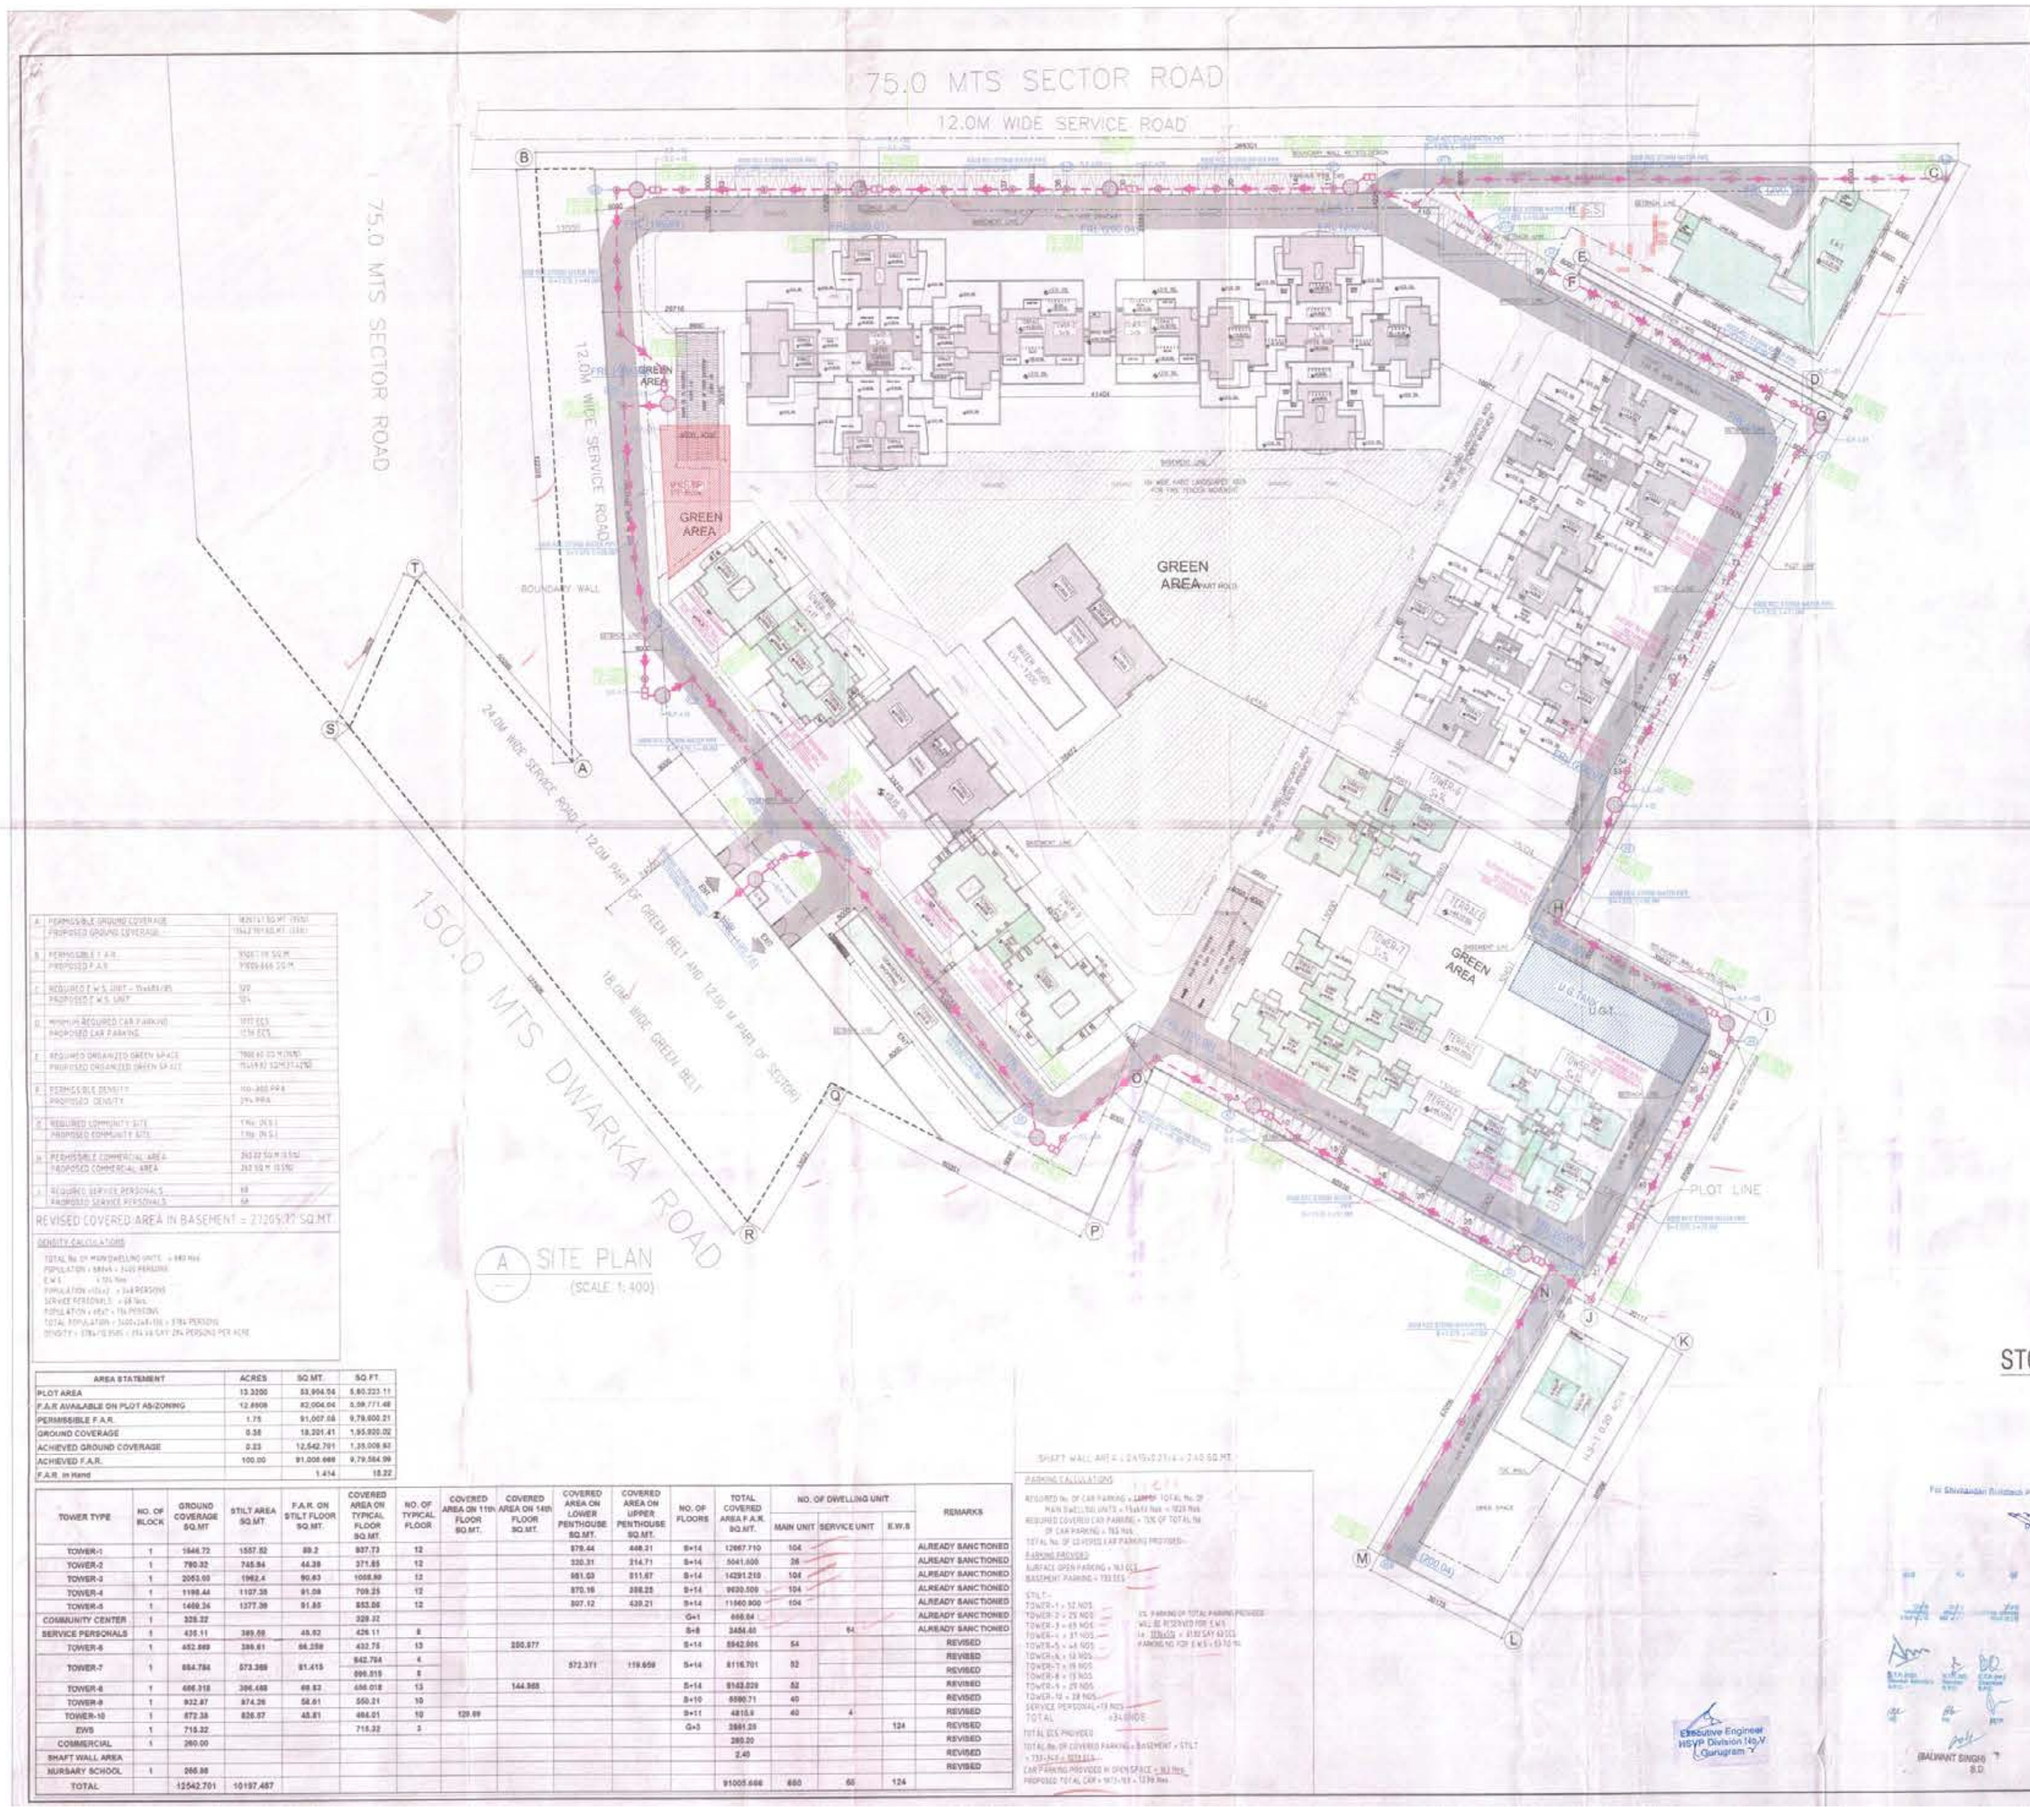

A SITE PLAN
(SCALE 1:400)

STRUCTURAL STABILITY CERTIFICATE

I CERTIFY THAT THE BUILDING PLANS FOR APPROVAL SATISFY THE SAFETY REQUIREMENTS AS STIPULATED UNDER CLAUSE 10 OF BUILDING BYE LAWS, AND AND THE INFORMATION GIVEN THEREIN IS FACTUALLY CORRECT TO THE BEST OF OUR KNOWLEDGE AND UNDERSTANDING.
IT IS ALSO CERTIFIED THAT THE STRUCTURAL DESIGN INCLUDES SAFETY FROM NATURAL HAZARDS BASED ON SITE CONDITION AND WILL ONLY INCORPORATED IN THE DESIGN OF BUILDING AND THESE PROVISIONS SHALL BE ADHERED TO DURING THE CONSTRUCTION

NOTE FOR BASEMENT

THE WALLS & FLOOR OF THE BASEMENT SHALL BE WATER TIGHT & SO DESIGNED THAT THE EFFECT OF THE SURROUNDING SOIL & WHATEVER IT MAY ARE TAKEN IN TO ACCOUNT IN DESIGN & ADEQUATE SUMP PROPING TREATMENT BE GIVEN

NOTE FOR WATER HARVESTING

I CERTIFY THAT THE BUILDING PLANS SUBMITTED FOR APPROVAL SATISFY THE WATER HARVESTING REQUIREMENTS AS WELL AS PROPER DISPOSAL/REUSE/REDUCE OF WASTE WATER AS STIPULATED UNDER CLAUSE 10.1.(2)(L) AND THE INFORMATION GIVEN THEREIN IS FACTUALLY CORRECT TO THE BEST OF OUR KNOWLEDGE AND UNDERSTANDING.
1. WASTE WATER RECYCLING SYSTEM SHALL BE INCORPORATED AT SITE THE RECYCLED WATER SHALL BE USED FOR AGRICULTURE PURPOSE

CERTIFICATE

2. DURING CONSTRUCTION IT IS MANDATORY ON THE PART OF THE OWNER TO ERECTED A SCREEN THE CONSTRUCTION SITE OF MAIN ROAD BY MEANS OF GRID TYPE SCREEN WALL NOT LESS THAN 8.0 M IN HEIGHT FROM GROUND LEVEL WHICH IS TO BE MAINTAINED TILL COMPLETION OF THE BUILDING.
NOTICE TO FIX A SET ON SAME SIZE OF THE CONSTRUCTED MATERIAL SHALL BE HOISTED AT THE FACADES OF THE BUILDING TO ENSURE THAT ANY FALLING MATERIAL REMAINS WITHIN THE PROTECTED AREA
3. NOISE RELATED ACTIVITIES WILL NOT BE TAKEN UP THE CONSTRUCTION AT NIGHT IN THE 10 pm

NOTE:-



ELECTRIC SUB STATION / GENERATION ROOM & PROVISIONS SHALL BE ON WELL GROUND NEAR FIRE CONTROL PANEL OR GROUND FLOOR ON IN UPPER BASEMENT AND IT SHALL BE LOCATED ON OUTER PERIMEMTER OF THE BUILDING THE SAFE SHALL BE GOT APPROVED FROM THE COMPETENT AUTHORITY

(II) SOLAR WATER HEATING SYSTEM

THE PROVISION OF SOLAR WATER HEATING SYSTEM SHALL BE AS PER NORMS SPECIFIED BY MNRES & AND SHALL BE MADE OPERATIONAL IN EACH BUILDING BODY BEFORE APPLYING FOR AN OCCUPATION CERTIFICATE

(III) RAIN WATER HARVESTING SYSTEM

THE RAIN WATER HARVESTING SYSTEM SHALL BE PROVIDED AS PER CENTRAL GROUND WATER AUTHORITY GUIDELINES/RAIN WATER HARVESTING AS APPLICABLE

NOTE

ALL TOILETS ARE MECHANICALLY LIT AND VENTILATED

NOTES

1 GATE AND BOUNDARY WALL AS STD. DESIGN
2 EXHAUST FAN TO BE PROVIDED IN ALL KITCHENS & TOILETS.
3 SPRINKLERS TO BE PROVIDED IN THE PREMISES AS PER NBC NORMS
4. 100% POWER BACKUP FOR RUNNING THE EMERGENCY SERVICES
5. TOILETS & POWDER ROOMS ARE MECHANICALLY VENTILATED AND LIT
6. BASEMENT ARE MECHANICALLY VENTILATED AND LIT
7. SERVICE AREA & LIFT ARE 100% POWER BACKUP

REVISED

ALREADY SANCTIONED

(RCC NP.3 PIPE)	EXTERNAL STORM WATER LINE
R.P.	RECHARGE PIT (3000 MM DIA)
D.C.	DESILTING CHAMBER (1000 x 2000)mm
	STORM WATER MANHOLE WITH 560D PERFORATED MANHOLE COVER

910 DIA CIRCULAR MANHOLE UPTO 1.68 M DEPTH
1220 DIA CIRCULAR MANHOLE UPTO 2.29 M DEPTH
1520 DIA CIRCULAR MANHOLE ABOVE 2.29 M DEPTH

Checked subject to comments in forwarding letter No. 602 Dt. 16/8/16 and notes attached with the estimate

Sub Divl. Engineer for Chief Engineer-cum-Patchkhas 16/8/16

Director Town and Country Planning Haryana, Chandigarh

STORM WATER WATER LAYOUT

A	PERMISSIBLE GROUND COVERAGE (40%) 18671.51 SQ.MT. (19551) PROPOSED GROUND COVERAGE 15542.701 SQ.MT. (33%)
B	PERMISSIBLE F.A.R. 93551.19 SQ.M. PROPOSED F.A.R. 91006.666 SQ.M.
C	REQUIRED E.W.S UNIT – 15%(81/8) PROPOSED E.W.S. UNIT 124
D	MINIMUM REQUIRED CAR PARKING 1177 ECS PROPOSED CAR PARKING 1174 ECS
E	REQUIRED ORGANIZED GREEN SPACE 7000.00 SQ.M.(15%) PROPOSED ORGANIZED GREEN SPACE 15149.93 SQM.(32.42%)
F	PERMISSIBLE DENSITY 100-400 PPA PROPOSED DENSITY 396 PPA
G	REQUIRED COMMUNITY SITE 1 No. (4 S.) PROPOSED COMMUNITY SITE 1 No. (4 S.)
H	PERMISSIBLE COMMERCIAL AREA 262.22 SQ.M (0.5%) PROPOSED COMMERCIAL AREA 262.50 M (0.5%)
I	REQUIRED SERVICE PERSONALS 68 PROPOSED SERVICE PERSONALS 68

REVISED COVERED AREA IN BASEMENT = 27205.77 SQ.MT.

DENSITY CALCULATIONS

TOTAL No. OF MAIN DWELLING UNITS = 880 Nos
POPULATION = 880x5 = 3400 PERSONS
E.W.S. = 124 Nos
POPULATION =124x3 = 372 PERSONS
SERVICE PERSONALS = 68 Nos
POPULATION = 68x5 = 136 PERSONS
TOTAL POPULATION = 3400+372+136 = 3784 PERSONS
DENSITY = 3784/19.1525 = 196.16 SAY 196 PERSONS PER ACRE

AREA STATEMENT	ACRES	SQ.MT.	SQ.FT.
PLOT AREA	13.3200	53,904.54	5,80,323.11
F.A.R AVAILABLE ON PLOT AS/ZONING	12.6908	92,004.04	9,99,771.48
PERMISSIBLE F.A.R.	1.75	91,007.66	9,79,600.21
GROUND COVERAGE	0.36	18,201.41	1,95,920.02
ACHIEVED GROUND COVERAGE	0.23	12,542.701	1,35,009.93
ACHIEVED F.A.R.	100.00	91,006.666	9,79,584.09
F.A.R. in Hand		1.414	15.22

TOWER TYPE	NO. OF BLOCK	GROUND COVERAGE SQ.MT	STILT AREA SQ.MT	F.A.R. ON STILT FLOOR SQ.MT.	COVERED AREA ON TYPICAL FLOOR SQ.MT.	NO. OF TYPICAL FLOOR	COVERED AREA ON 11th FLOOR SQ.MT.	COVERED AREA ON 14th FLOOR SQ.MT.	COVERED AREA ON LOWER PENTHOUSE SQ.MT.	COVERED AREA ON UPPER PENTHOUSE SQ.MT.	NO. OF FLOORS	TOTAL COVERED AREA F.A.R. SQ.MT.	NO. OF DWELLING UNIT MAIN UNIT	SERVICE UNIT	E.W.S	REMARKS
TOWER-1	1	1646.72	1557.52	89.2	937.73	12			675.44	448.31	S+14	12667.710	104			ALREADY SANCTIONED
TOWER-2	1	790.32	745.94	44.38	371.85	12			320.31	214.71	S+14	5041.605	28			ALREADY SANCTIONED
TOWER-3	1	2053.00	1962.4	90.63	1058.90	12			861.03	511.67	S+14	14291.210	104			ALREADY SANCTIONED
TOWER-4	1	1198.44	1107.35	91.09	709.25	12			870.16	398.25	S+14	9630.509	104			ALREADY SANCTIONED
TOWER-5	1	1409.34	1377.39	91.85	853.06	12			807.12	430.21	S+14	11560.900	104			ALREADY SANCTIONED
COMMUNITY CENTER	1	328.32			328.32						G+1	656.64				ALREADY SANCTIONED
SERVICE PERSONALS	1	435.11	389.68	45.52	426.11	8					S+8	3454.60		64		ALREADY SANCTIONED
TOWER-6	1	452.969	386.61	66.359	432.75	13		290.977			S+14	5942.991	54			REVISED
TOWER-7	1	664.784	573.369	91.415	842.784	4			572.371	119.659	S+14	8116.701	52			REVISED
					696.019	8										REVISED
TOWER-8	1	406.318	396.488	69.83	486.018	13		144.368			S+14	6143.829	52			REVISED
TOWER-9	1	932.87	874.26	58.61	550.21	10					S+10	5590.71	40			REVISED
TOWER-10	1	872.38	826.57	45.81	484.01	10	129.99				S+11	4815.9	40	4		REVISED
EWS	1	715.32			715.32	3					G+3	3861.28			124	REVISED
COMMERCIAL	1	260.00										260.00				REVISED
SHAFT WALL AREA												2.40				REVISED
NURSARY SCHOOL	1	266.98														REVISED
TOTAL		12542.701	10197.487									91005.666	680	68	124	

SHAFT WALL AREA = (0.6x0.2)x4 = 2.40 SQ.MT

PARKING CALCULATIONS

REQUIRED No. OF CAR PARKING = 1177 TOTAL No. OF MAIN DWELLING UNITS = 15x680 Nos = 1020 Nos
REQUIRED COVERED CAR PARKING = 10% OF TOTAL No. OF CAR PARKING = 765 Nos
TOTAL No. OF CO-VERED CAR PARKING PROVIDED=
PARKING PROVIDED
SURFACE OPEN PARKING = 163 ECS
BASEMENT PARKING = 1011 ECS
STILT :-
TOWER-1 = 52 NOS
TOWER-2 = 25 NOS
TOWER-3 = 65 NOS
TOWER-4 = 37 NOS
TOWER-5 = 44 NOS
TOWER-6 = 12 NOS
TOWER-7 = 16 NOS
TOWER-8 = 13 NOS
TOWER-9 = 29 NOS
TOWER-10 = 28 NOS
SERVICE PERSONAL=13 NOS
TOTAL = 334 NOS
10% PARKING OF TOTAL PARKING PROVIDED WILL BE RESERVED FOR E.W.S
i.e. 1174x10% = 117.4 SAY 117 ECS
PARKING NO FOR E.W.S = 13 TO 14
TOTAL ECS PROVIDED
TOTAL No. OF COVERED PARKING = BASEMENT + STILT
= 1011+334 = 1345 ECS
CAR PARKING PROVIDED IN OPEN SPACE = 163 Nos
PROPOSED TOTAL CAR = 1473-163 = 1310 Nos

For Shivnandan Buildtech Pvt. Ltd.
Director

Executive Engineer HSVP Division No.V Gurugram

(BALWANT SINGH) S.D.

OWNER'S SIGN	ARCHITECT'S SIGN
Director	ARCHITECT RAJESH JAIN CA/88/13609

Project: REVISED & PROPOSED BUILDING PLANS OF GROUP HOUSING SCHEME AREA MEASURING 13.32 ACRE LICENCE NO 70 OF 2011 DATED 22.07.2011 & LICENCE NO 10 OF 2012 DATED 21.02.2012 IN SECTOR 99 GURGAON MANESAR URBAN COMPLEX

Client: M/S SHIVNANDAN BUILDTECH PVT. LTD

SCALE: AS SHOWN

DATE : 27-AUG-2013

DRAWN: KJ — SUBMISSION DRAWING
CHECKED: S.K — STIT PLAN
APPROVED: R.J
DRG. NO. 01 — REV. NO

Ichinen ARCHITECTS PRIVATE LIMITED
A-19 DARIYAGANJ ENCLAVE, NEW DELHI-110002
TELEPHONE: +91 11 46556892, EMAIL: ichinenarchitects@gmail.com

Checked and Noted as Per Public Health Branch Service Note subject to comments in forwarding letter No. 602 Dt. 16/8/16

Superintending Engineer (PH) HSVP, Panchkula

Chief Engineer HSVP Gurugram

NOTE:
THE OWNER & PROMOTER OF SUBJECT PROJECT IS SOLE RESPONSIBLE FOR CARRYING OUT THE SAID PROJECT STRICTLY AS PER THE APPROVED PLANS & IN CASE ANY DEVIATION OF THE OWNERS

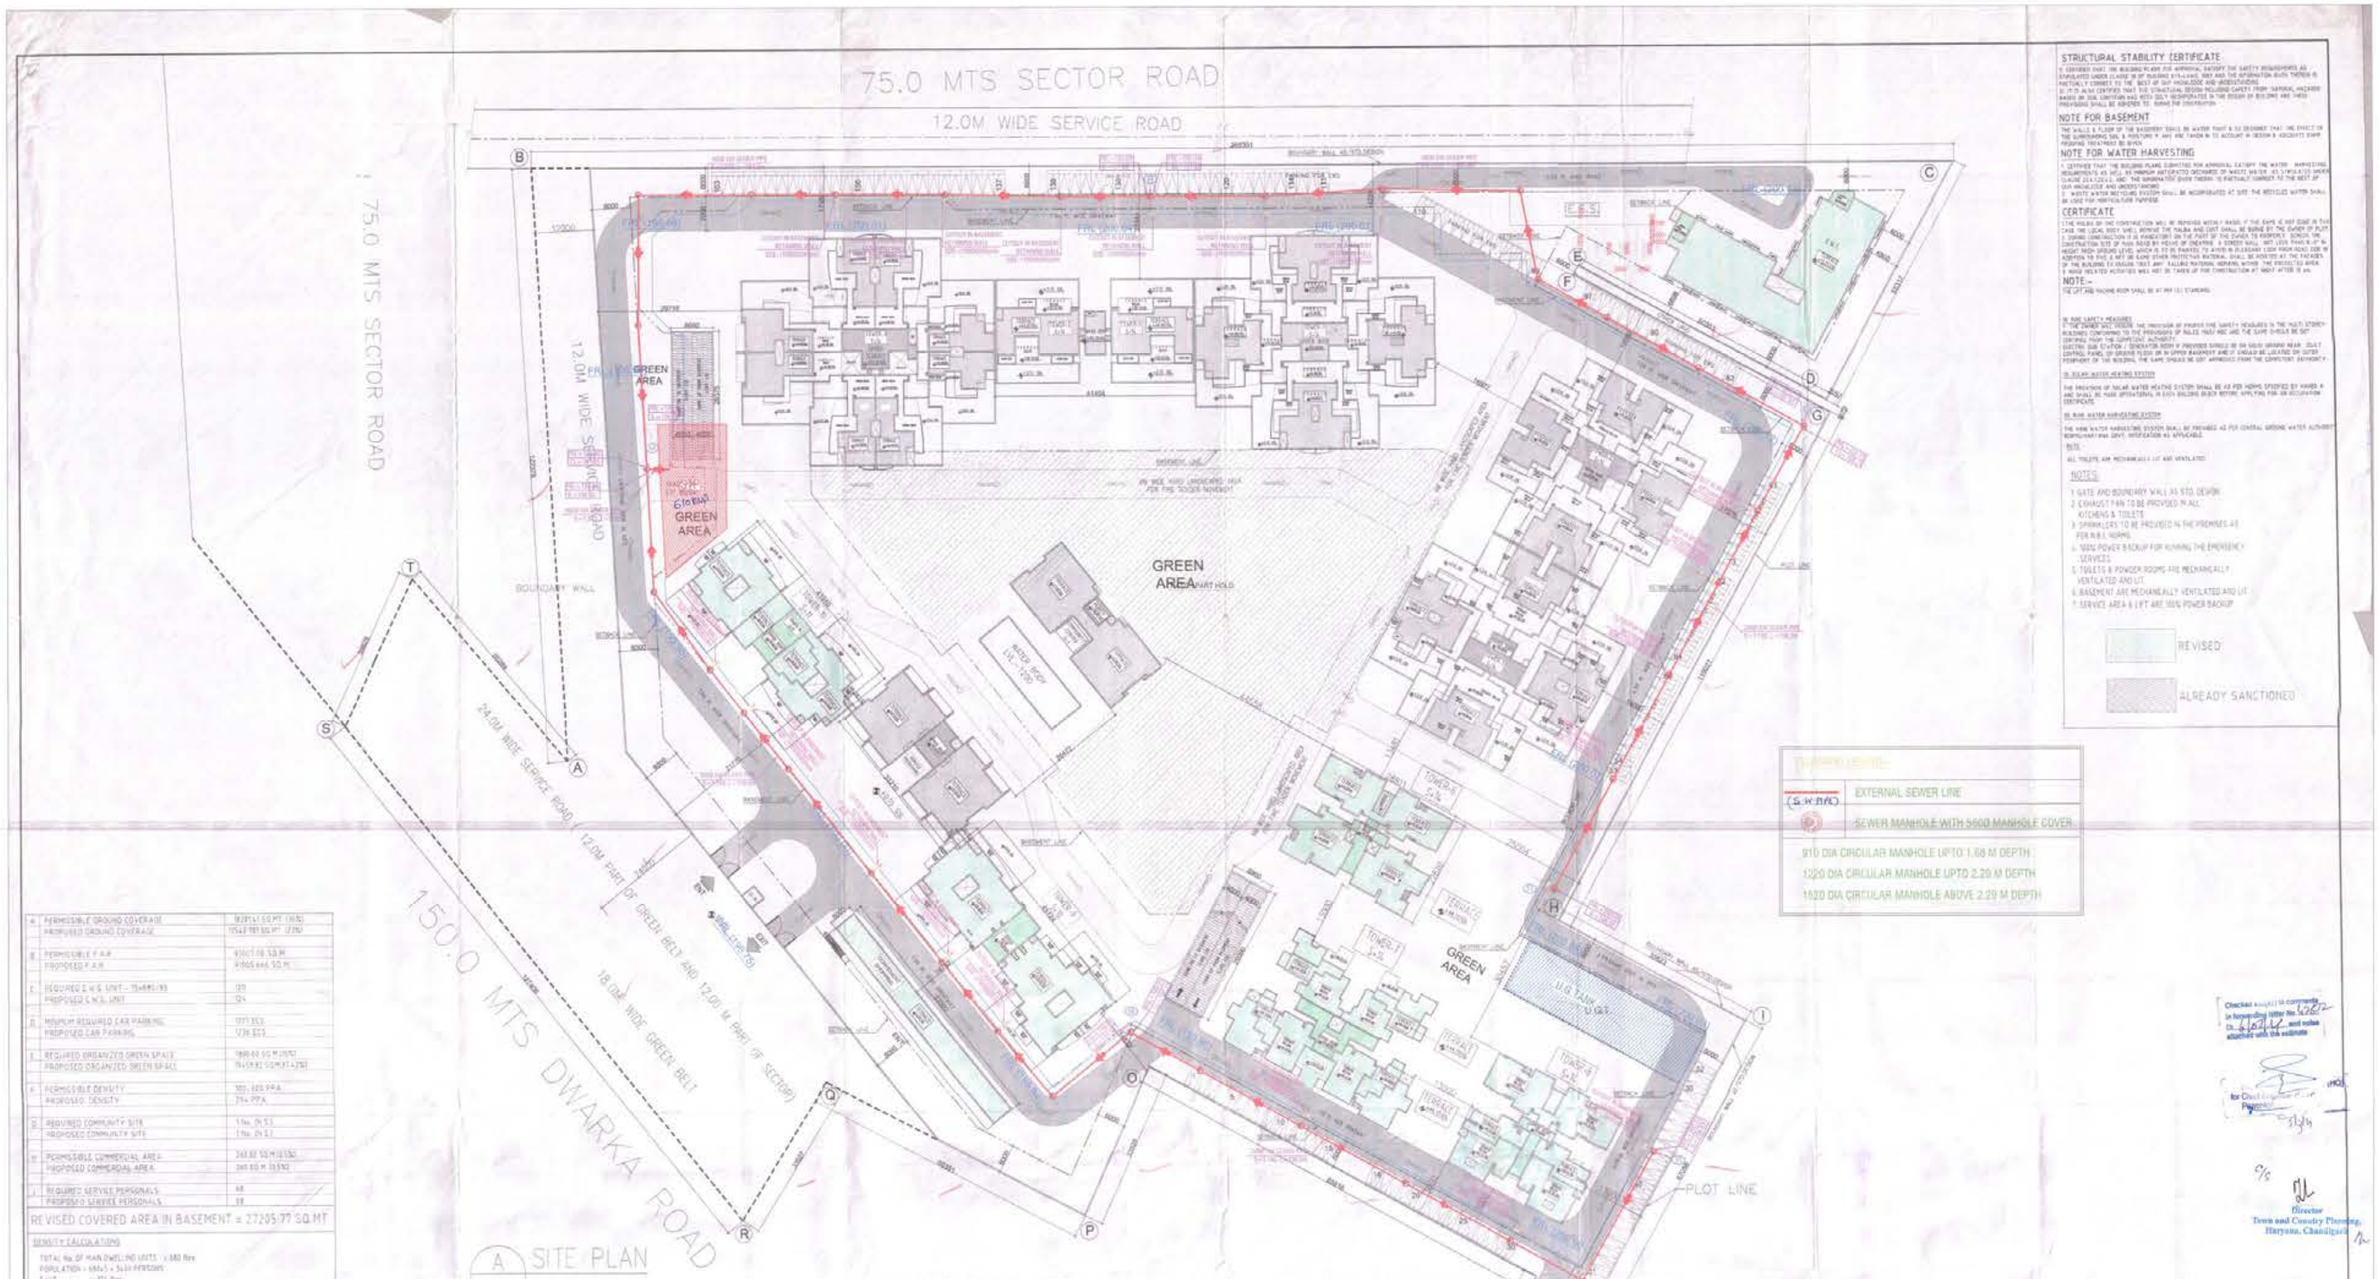

A SITE PLAN
(SCALE 1:400)

STRUCTURAL STABILITY CERTIFICATE

I CERTIFIED THAT THE BUILDING PLANS SUBMITTED FOR APPROVAL SATISFY THE SAFETY REQUIREMENTS AS STIPULATED UNDER CLAUSE 38 OF BUILDING BYE-LAWS, 1983 AND THE INFORMATION GIVEN THEREIN IS FACTUALLY CORRECT TO THE BEST OF OUR KNOWLEDGE AND ABSOLUTION.

IT IS ALSO CERTIFIED THAT THE STRUCTURAL DESIGN INCLUDES SAFETY FROM NATURAL HAZARDS MADE IN THE LIMITATION AND NOT OUR RESPONSIBILITY IN THE DESIGN IN BUILDING AND THESE PROVISIONS SHALL BE ADHERED TO DURING THE CONSTRUCTION.

NOTE FOR BASEMENT

THE WALLS & FLOOR OF THE BASEMENT SHALL BE WATER TIGHT & SO DESIGNED THAT THE EFFECT OF THE SURROUNDING SOIL & MOISTURE IF ANY ARE TAKEN IN TO ACCOUNT IN DESIGN & ADEQUATE DAMP PROOFING TREATMENT BE GIVEN.

NOTE FOR WATER HARVESTING

1. CERTIFIED THAT THE BUILDING PLANS SUBMITTED FOR APPROVAL SATISFY THE WATER HARVESTING REQUIREMENTS AS WELL AS PROPER ANTICIPATED DISCHARGE OF WASTE WATER AS STIPULATED UNDER CLAUSE 22.4.2.2.1, AND THE INFORMATION GIVEN THEREIN IS FACTUALLY CORRECT TO THE BEST OF OUR KNOWLEDGE AND ABOVE STATED.
2. WASTE WATER RECYCLING SYSTEM SHALL BE INCORPORATED AT SITE THE RECYCLED WATER SHALL BE USED FOR HORTICULTURE PURPOSE.

CERTIFICATE

1. THE PILLARS OF RCC CONSTRUCTION WILL BE REMOVED WITHIN 7 DAYS IF THE GAPS IS NOT DONE IN THIS CASE THE LOCAL BODY SHALL REMOVE THE PILLAR AND COST SHALL BE BORNE BY THE OWNER OF PLOT.
2. DURING CONSTRUCTION IT IS MANDATORY ON THE PART OF THE OWNER TO PROVIDE A SCREEN ON CONSTRUCTION SITE OF THIS AREA IN HEIGHT OF OWNERS. A SCREEN WALL NOT LESS THAN 6.0 M HEIGHT FROM GROUND LEVEL WHICH IS TO BE PAINTED TO AVOID AN UNPLEASANT LOOK FROM ROAD SIDE IN ADDITION TO THIS A NET OR SOME OTHER PROTECTIVE MATERIAL SHALL BE HOISTED AT THE FACADES OF THE BUILDING TO ENSURE THAT ANY FALLING MATERIAL HAPPENS WITHIN THE PROTECTED AREA.
3. NOISE POLLUTED ACTIVITIES WILL NOT BE TAKEN UP FOR CONSTRUCTION AT NIGHT AFTER 8 pm

NOTE:-
THE LIFT AND PUMPING MOTOR SHALL BE AT PLINTH LEVEL STANDING.

IN FIRE SAFETY MEASURES
1. THE OWNER WILL DESIGN THE PROVISION OF ADEQUATE FIRE SAFETY MEASURES IN THE MULTI STOREY BUILDINGS CONFORMING TO THE PROVISIONS OF RULES FIRE AND THE SAME SHOULD BE GOT CERTIFIED FROM THE COMPETENT AUTHORITY.
ELECTRIC SUB STATION / GENERATOR ROOM IF PROVIDED SHOULD BE ON GROUND GROUND FLOOR, SUCH CERTIFIED PLANS, ON GROUND FLOOR OR IN UPPER BASEMENT AND IT SHOULD BE LICENSE OR OTHER PERMANENT OF THE BUILDING THE SAME SHOULD BE GOT APPROVED FROM THE COMPETENT AUTHORITY.

IN SOLAR WATER HEATING SYSTEM

THE PROVISION OF SOLAR WATER HEATING SYSTEM SHALL BE AS PER NORMS SPECIFIED BY NABEA & AND SHALL BE MADE OPERATIONAL IN EACH BUILDING BLOCK BEFORE APPLYING FOR AN OCCUPATION CERTIFICATE.

IN RAIN WATER HARVESTING SYSTEM

THE RAIN WATER HARVESTING SYSTEM SHALL BE PROVIDED AS PER CENTRAL GROUND WATER AUTHORITY NORMS/HARYANA GOVT. NOTIFICATION AS APPLICABLE.

NOTE

ALL TOILETS ARE MECHANICALLY LIT AND VENTILATED

NOTES

1. GATE AND BOUNDARY WALL AS STD. DESIGN
2. EXHAUST FAN TO BE PROVIDED IN ALL KITCHENS & TOILETS
3. SPRINKLERS TO BE PROVIDED IN THE PREMISES AS PER N.B.C. NORMS
4. 100% POWER BACKUP FOR RUNNING THE EMERGENCY SERVICES
5. TOILETS & POWDER ROOMS ARE MECHANICALLY VENTILATED AND LIT
6. BASEMENT ARE MECHANICALLY VENTILATED AND LIT
7. SERVICE AREA & LIFT ARE 100% POWER BACKUP

REVISED

ALREADY SANCTIONED

A	PERMISSIBLE GROUND COVERAGE PROPOSED GROUND COVERAGE	18201.50 SQ.MT (33%) 17547.99 SQ.MT (32%)
B	PERMISSIBLE F.A.R PROPOSED F.A.R	91007.09 SQ.M 91005.666 SQ.M
C	REQUIRED E.W.S. UNIT – 15% PROPOSED E.W.S. UNIT	120 124
D	MINIMUM REQUIRED CAR PARKING PROPOSED CAR PARKING	1777 ECS 1736 ECS
E	REQUIRED ORGANIZED GREEN SPACE PROPOSED ORGANIZED GREEN SPACE	1820.18 SQ.M (15%) 7415.93 SQ.M (41.25%)
F	PERMISSIBLE DENSITY PROPOSED DENSITY	350 PPA 294 PPA
G	REQUIRED COMMUNITY SITE PROPOSED COMMUNITY SITE	1 No. (4 ECS) 1 No. (4 ECS)
H	PERMISSIBLE COMMERCIAL AREA PROPOSED COMMERCIAL AREA	240.80 SQ.M (0.5%) 240.80 M (0.5%)
I	REQUIRED SERVICE PERSONALS PROPOSED SERVICE PERSONALS	68 68

REVISED COVERED AREA IN BASEMENT = 27205.77 SQ.MT

DENSITY CALCULATIONS

TOTAL No. OF MAIN DWELLING UNITS : = 680 Nos
POPULATION = (680x5) = 3400 PERSONS
E.W.S. = 124 Nos
POPULATION (124x4) = 496 PERSONS
SERVICE PERSONALS : = 68 Nos
POPULATION = (68x4) = 272 PERSONS
TOTAL POPULATION = (3400+496+272) = 4168 PERSONS
DENSITY = (4168/14.18) = 294.08 SAY 294 PERSONS PER ACRE

AREA STATEMENT	ACRES	SQ.MT.	SQ.FT
PLOT AREA	13.3200	53,904.04	5,80,322.11
F.A.R AVAILABLE ON PLOT AS-ZONING	12.6505	82,004.04	8,59,771.46
PERMISSIBLE F.A.R	1.75	91,007.09	9,79,600.21
GROUND COVERAGE	0.35	18,201.41	1,95,930.02
ACHIEVED GROUND COVERAGE	0.33	12,542.701	1,35,008.63
ACHIEVED F.A.R.	100.00	91,005.666	9,79,584.99
F.A.R. in Hand		1.414	15.22

TOWER TYPE	NO. OF BLOCK	GROUND COVERAGE SQ.MT	STILT AREA SQ.MT.	F.A.R. ON STILT FLOOR SQ.MT.	COVERED AREA ON TYPICAL FLOOR SQ.MT.	NO. OF TYPICAL FLOOR	COVERED AREA ON 11th FLOOR SQ.MT.	COVERED AREA ON 14th FLOOR SQ.MT.	COVERED AREA ON LOWER PENTHOUSE SQ.MT.	COVERED AREA ON UPPER PENTHOUSE SQ.MT.	NO. OF FLOORS	TOTAL COVERED AREA F.A.R. SQ.MT.	NO. OF DWELLING UNIT			REMARKS
													MAIN UNIT	SERVICE UNIT	E.W.S	
TOWER-1	1	1546.72	1557.02	89.2	937.72	12			679.44	446.31	B+14	12867.710	104			ALREADY SANCTIONED
TOWER-2	1	790.32	746.64	44.38	371.85	12			320.31	214.71	B+14	5041.600	28			ALREADY SANCTIONED
TOWER-3	1	2053.03	1962.4	80.63	1068.99	12			901.03	511.67	B+14	14291.210	104			ALREADY SANCTIONED
TOWER-4	1	1158.44	1107.36	81.09	709.25	12			670.16	388.25	B+14	9630.500	104			ALREADY SANCTIONED
TOWER-5	1	1409.24	1377.39	81.66	953.06	12			807.12	426.21	B+14	11550.600	104			ALREADY SANCTIONED
COMMUNITY CENTER	1	328.32			328.32						G+1	656.64				ALREADY SANCTIONED
SERVICE PERSONALS	1	435.11	389.59	45.52	426.11	8					B+8	3404.40		44		ALREADY SANCTIONED
TOWER-6	1	402.888	386.61	86.258	432.75	13		260.977			B+14	5642.866	64			REVISED
TOWER-7	1	664.784	673.349	81.415	842.784	4			572.371	119.888	B+14	8116.701	82			REVISED
					594.015	8										REVISED
TOWER-8	1	466.318	396.488	89.83	486.018	13		144.988			B+14	6143.029	52			REVISED
TOWER-9	1	932.87	874.26	88.61	560.21	10					B+10	6560.71	40			REVISED
TOWER-10	1	972.28	826.57	49.61	464.01	10	129.68				B+11	4815.8	40	4		REVISED
EWS	1	716.32			715.32	3					G+3	2861.28			124	REVISED
COMMERCIAL	1	260.00										260.00				REVISED
SHAFT WALL AREA												2.40				REVISED
NURSARY SCHOOL	1	205.98														REVISED
TOTAL		12542.701	10197.487									91005.666	680	68	124	

SHAFT WALL AREA = 2.4 SQ.MT

PARKING CALCULATION

REQUIRED No. OF CAR PARKING = 1.5 PER TOTAL No. OF MAIN DWELLING UNITS = 1.5x680 Nos = 1020 Nos
REQUIRED COVERED CAR PARKING = 75% OF TOTAL No. OF CAR PARKING = 765 Nos
TOTAL No. OF COVERED CAR PARKING PROVIDED =

PARKING PROVIDED

SURFACE OPEN PARKING = 148 ECS
BASEMENT PARKING = 733 ECS

STILT =
TOWER-1 = 52 NOS
TOWER-2 = 25 NOS
TOWER-3 = 65 NOS
TOWER-4 = 33 NOS
TOWER-5 = 44 NOS
TOWER-6 = 13 NOS
TOWER-7 = 16 NOS
TOWER-8 = 13 NOS
TOWER-9 = 20 NOS
TOWER-10 = 28 NOS
SERVICE PERSONAL = 15 NOS
TOTAL = 344 NOS

10% PARKING OF TOTAL PARKING PROVIDED WILL BE RESERVED FOR E.W.S.
(4 TENATS = 3 NOS SAY 4 ECS PARKING NO FOR E.W.S = 10 TO 14)

TOTAL ECS PROVIDED
TOTAL No. OF COVERED PARKING = BASEMENT + STILT = 733+344 = 1077 ECS
CAR PARKING PROVIDED IN OPEN SPACE = 148 Nos
PROPOSED TOTAL CAR = 1077+148 = 1225 Nos

SEWER LAYOUT

Checked and found in conformity in forwarding letter No. 6282 Dt. 6/8/12 and notes attached with the estimate

for Chief Engineer (HQ)
Planning
5/8

Director
Town and Country Planning, Haryana, Chandigarh

For Shivanandan Buildtech Pvt. Ltd.
Director

Executive Engineer HSVP Division No.V (Gurugram)

(BALWANT SINGH)
S.D.

Checked and found ok for Public Health (Sewer) Services from unique no. mentioned in forwarding letter No. 10/2012 Dt. 6/8/12

Superintending Engineer (HQ) PHEW, Panchkula

OWNER'S SIGN. — Director
ARCHITECT'S SIGN. — ARCHITECT RAJESH JAIN CA/87/1209

Project: REVISED & PROPOSED BUILDING PLANS OF GROUP HOUSING SCHEME AREA MEASURING 13.32 ACRE LICENCE NO.76 OF 2011 DATED 28.07.2011 & LICENCE NO.92 OF 2012 DATED 27.08.2012 IN SECTOR 99 GURGAON MANESAR URBAN COMPLEX

Client: M/S BHINNANDAN BUILDTECH PVT. LTD.

SCALE: AS SHOWN
DATE: 27-JUNE-2013
DRAWN: K.J. — SUPERVISOR DRAWING
CHECKED: R.A.
APPROVED: R.J.
DRG. NO. 01 — REV. NO
PROJECT:

Ichinen ARCHITECTS PRIVATE LIMITED
4-B, DARYAGANJ KIOSKS, NEW DELHI-110002
TELEPHONE: +91 11 45528800, EMAIL: ichinenarchitects@gmail.com

Chief Engineer

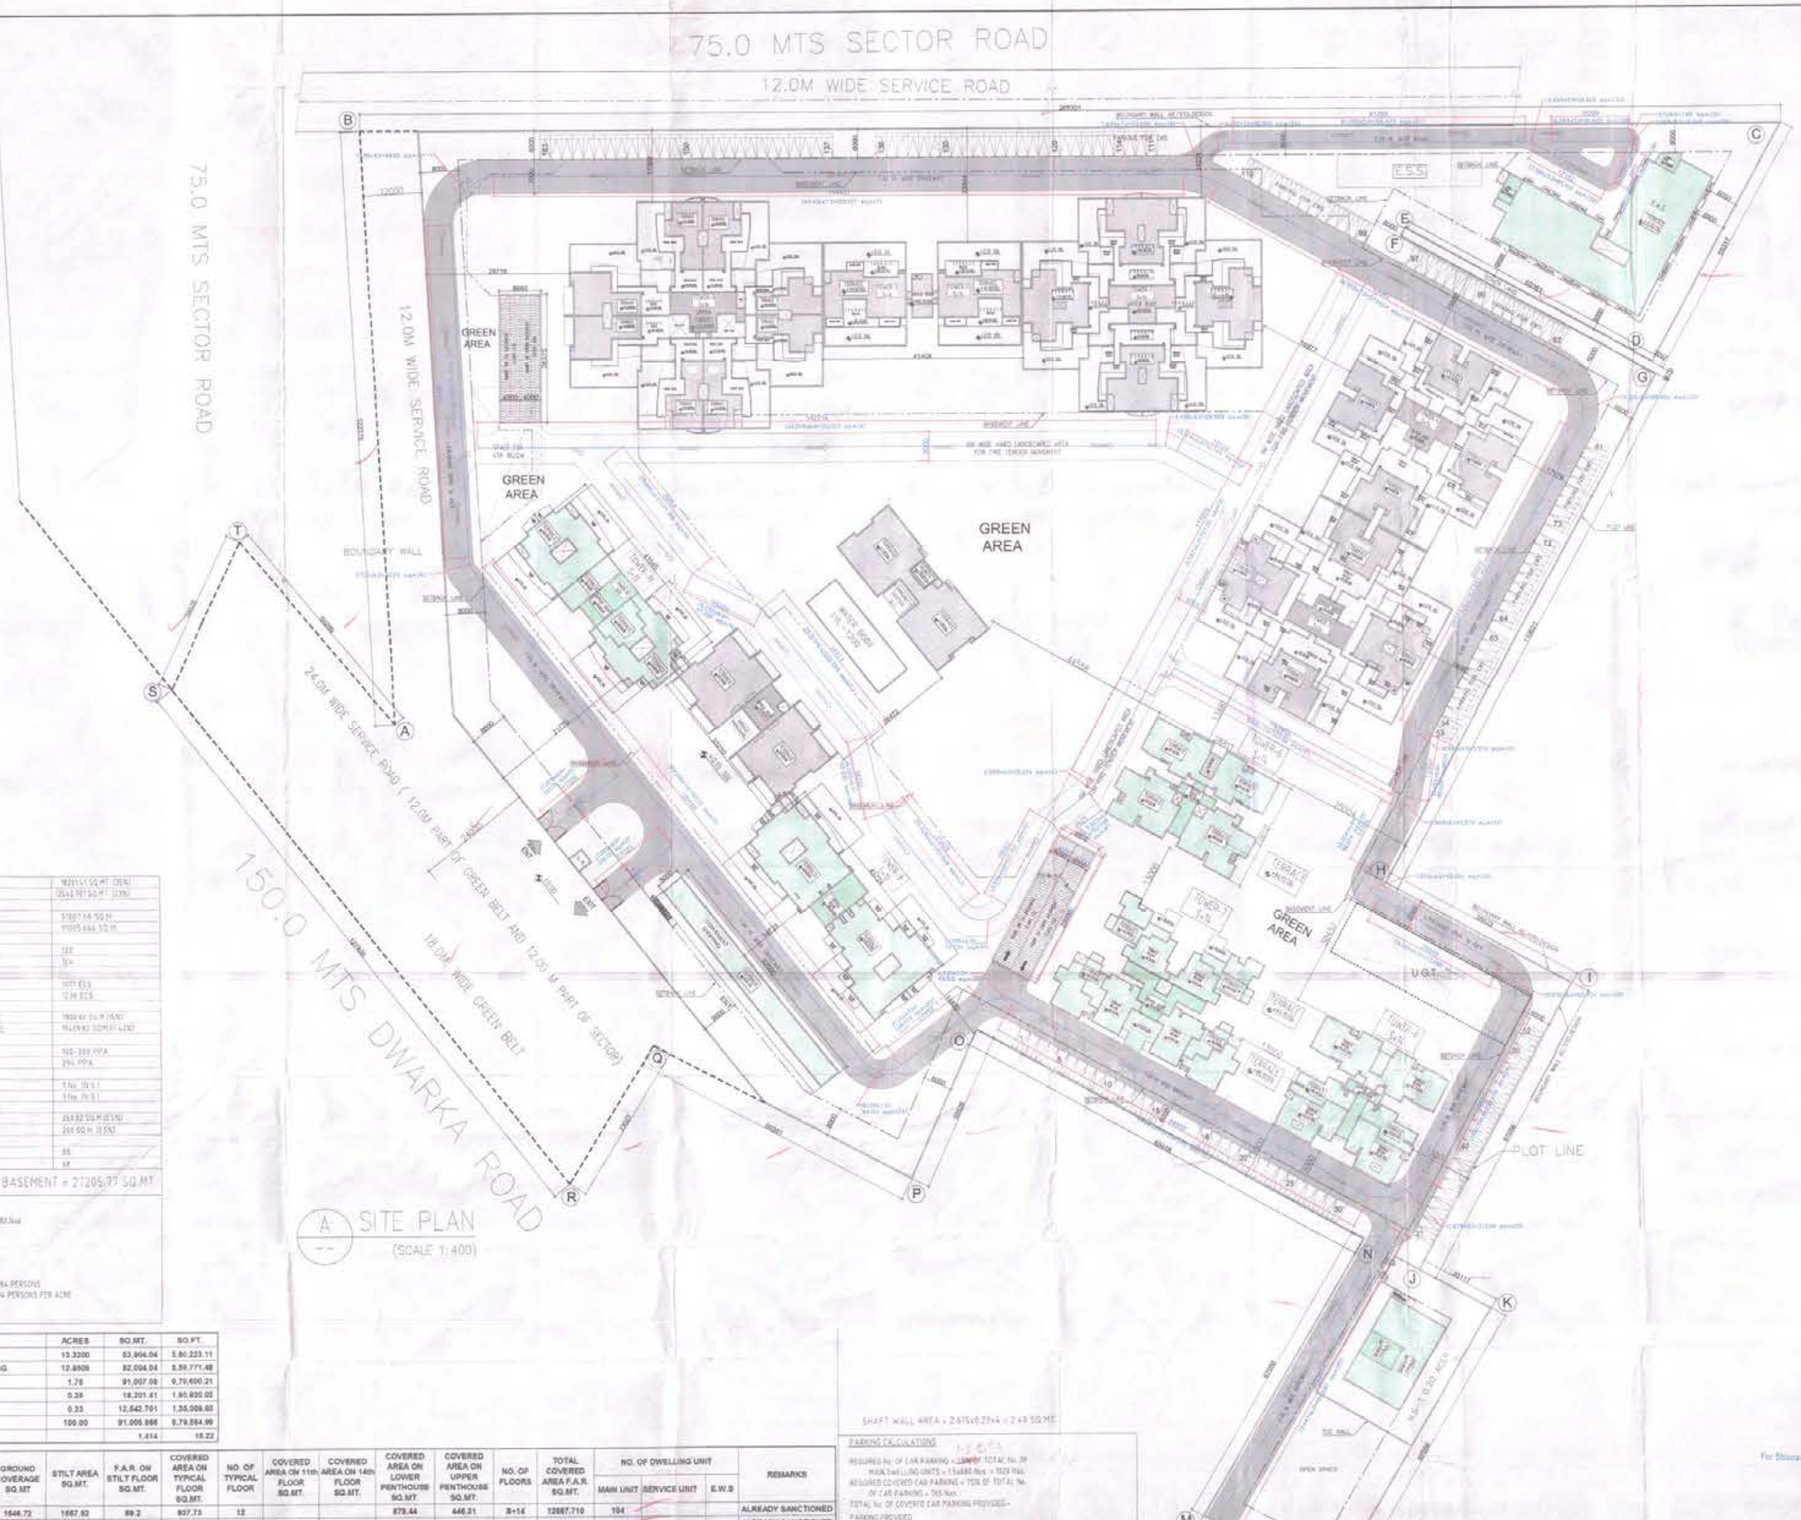

A	PERMISSIBLE GROUND COVERAGE PROPOSED GROUND COVERAGE	18211.12 M² (33%) 12542.701 M² (23%)
B	PERMISSIBLE F.A.R. PROPOSED F.A.R.	91007.08 SQ.M. 91005.666 SQ.M.
C	REQUIRED E.W.S. UNIT - 15x680/85 PROPOSED E.W.S. UNIT	120 124
D	MINIMUM REQUIRED CAR PARKING PROPOSED CAR PARKING	1077 ECS 1236 ECS
E	REQUIRED ORGANIZED GREEN SPACE PROPOSED ORGANIZED GREEN SPACE	7600.00 SQ.M.(15%) 19429.92 SQ.M.(37.93%)
F	PERMISSIBLE DENSITY PROPOSED DENSITY	100-200 PPA 296 PPA
G	REQUIRED COMMUNITY SITE PROPOSED COMMUNITY SITE	1 No. (N.S.) 1 No. (N.S.)
H	PERMISSIBLE COMMERCIAL AREA PROPOSED COMMERCIAL AREA	2532.92 SQ.M.(5%) 266 SQ.M. (0.5%)
I	REQUIRED SERVICE PERSONALS PROPOSED SERVICE PERSONALS	55 58

REVISED COVERED AREA IN BASEMENT = 27205.97 SQ.MT

DENSITY CALCULATIONS


AREA STATEMENT	ACRES	SQ.MT.	SQ.FT.
PLOT AREA	13.3200	53,904.04	5,80,223.11
F.A.R AVAILABLE ON PLOT AS/ZONING	12.8906	82,004.04	8,59,771.48
PERMISSIBLE F.A.R.	1.75	91,007.08	9,79,600.21
GROUND COVERAGE	0.38	18,201.41	1,95,920.02
ACHIEVED GROUND COVERAGE	0.33	12,542.701	1,35,009.03
ACHIEVED F.A.R.	100.00	91,005.666	9,79,664.99
F.A.R. In Hand		1.414	15.22

TOWER TYPE	NO. OF BLOCK	GROUND COVERAGE SQ.MT	STILT AREA SQ.MT.	F.A.R. ON STILT FLOOR SQ.MT.	COVERED AREA ON TYPICAL FLOOR SQ.MT.	NO. OF TYPICAL FLOOR	COVERED AREA ON 11th FLOOR SQ.MT.	COVERED AREA ON 14th FLOOR SQ.MT.	COVERED AREA ON LOWER PENTHOUSE SQ.MT.	COVERED AREA ON UPPER PENTHOUSE SQ.MT.	NO. OF FLOORS	TOTAL COVERED AREA F.A.R. SQ.MT.	NO. OF DWELLING UNIT			REMARKS
													MAIN UNIT	SERVICE UNIT	E.W.S	
TOWER-1	1	1646.72	1667.82	89.2	937.73	12			879.44	446.31	S+14	12687.710	104			ALREADY SANCTIONED
TOWER-2	1	790.32	745.94	44.38	371.86	12			320.31	214.71	S+14	5041.800	26			ALREADY SANCTIONED
TOWER-3	1	2063.03	1962.4	90.63	1088.89	12			891.03	511.67	S+14	14291.210	104			ALREADY SANCTIONED
TOWER-4	1	1189.44	1107.35	91.09	709.25	12			670.16	358.25	S+14	9630.500	104			ALREADY SANCTIONED
TOWER-5	1	1469.24	1377.39	91.85	853.06	12			807.12	426.21	S+14	11560.800	104			ALREADY SANCTIONED
COMMUNITY CENTER	1	328.32			328.32						G+1	656.64				ALREADY SANCTIONED
SERVICE PERSONALS	1	435.11	389.58	45.52	428.11	8					S+8	3424.40		64		ALREADY SANCTIONED
TOWER-6	1	482.999	396.61	86.259	432.78	13		250.977			S+14	5842.588	84			REVISED
TOWER-7	1	654.784	573.369	81.415	642.784	4			972.371	119.699	S+16	8118.701	92			REVISED
					896.015	8										REVISED
TOWER-8	1	486.318	396.488	89.83	456.015	13		144.989			S+14	6143.029	82			REVISED
TOWER-9	1	932.87	874.26	58.61	590.21	10					S+10	5560.71	48			REVISED
TOWER-10	1	872.38	826.67	45.71	484.01	10	129.88				S+11	4815.6	40	4		REVISED
EWS	1	715.32			715.32	3					G+3	2861.28			124	REVISED
COMMERCIAL	1	266.00										266.00				REVISED
SHAFT WALL AREA												2.49				REVISED
NURSARY SCHOOL	1	266.00														REVISED
TOTAL		12542.701	10197.487									91005.666	680	68	124	

SHAFT WALL AREA = 2.675x0.27x4 = 2.49 SQ.MT

PARKING CALCULATIONS

REQUIRED No. OF CAR PARKING = 1077 (TOTAL No. OF MAIN DWELLING UNITS = 15x680 Nos = 1020 Nos.
REQUIRED COVERED CAR PARKING = 75% OF TOTAL No. OF CAR PARKING = 765 Nos
TOTAL No. OF COVERED CAR PARKING PROVIDED -

PARKING PROVIDED
SURFACE OPEN PARKING = 483 ECS
BASEMENT PARKING = 753 ECS

STILT -
TOWER-1 = 52 NOS.
TOWER-2 = 25 NOS.
TOWER-3 = 65 NOS.
TOWER-4 = 37 NOS.
TOWER-5 = 44 NOS.
TOWER-6 = 13 NOS.
TOWER-7 = 19 NOS.
TOWER-8 = 13 NOS.
TOWER-9 = 29 NOS.
TOWER-10 = 28 NOS.
SERVICE PERSONAL = 13 NOS.
TOTAL = 340 NOS

5% PARKING OF TOTAL PARKING PROVIDED WILL BE RESERVED FOR E.W.S
i.e. 340x5% = 17.00 SAY 42 ECS
PARKING REQ. FOR E.W.S = 33 ECS

TOTAL ECS PROVIDED
TOTAL No. OF COVERED PARKING = BASEMENT + STILT
= 753+340 = 1093 ECS
CAR PARKING PROVIDED IN OPEN SPACE = 143 Nos
PROPOSED TOTAL CAR = 1093+143 = 1236 Nos.

STRUCTURAL STABILITY CERTIFICATE

IT CERTIFIES THAT THE BUILDING PLANS FOR APPROVAL SATISFY THE SAFETY REQUIREMENTS AS STIPULATED UNDER CLAUSE 33 OF THE BUILDING BYE-LAWS, 1983 AND THE INFORMATION GIVEN THEREIN IS FACTUALLY CORRECT TO THE BEST OF OUR KNOWLEDGE AND UNDERSTANDING.
IT IS ALSO CERTIFIED THAT THE STRUCTURAL DESIGN INCLUDING SAFETY FROM NATURAL HAZARDS BASED ON SOIL CONDITION AND WITH ONLY RESPONSIBILITY IN THE DESIGN OF BUILDING AND THESE PROVISIONS SHALL BE ADHERED TO DURING THE CONSTRUCTION

NOTE FOR BASEMENT

THE WALLS & FLOOR OF THE BASEMENT SHALL BE WATER TIGHT & SO DESIGNED THAT THE EFFECT OF THE SURROUNDING SOIL & MOISTURE IF ANY ARE TAKEN IN TO ACCOUNT IN DESIGN & ADEQUATE DAMP PROOFING TREATMENT BE GIVEN

NOTE FOR WATER HARVESTING

I CERTIFIED THAT THE BUILDING PLANS SUBMITTED FOR APPROVAL SATISFY THE WATER - HARVESTING REQUIREMENTS AS LAID - IN RAINFALL ANTICIPATED RECHARGE OF WATER WATER AS STIPULATED UNDER CLAUSE 22.4.1(2) AND THE INFORMATION GIVEN THEREIN IS FACTUALLY CORRECT TO THE BEST OF OUR KNOWLEDGE AND BELIEF.
A WASTE WATER RECYCLING SYSTEM SHALL BE INCORPORATED AT SITE THE RECYCLED WATER SHALL BE USED FOR VARIOUS PURPOSE

CERTIFICATE

THE PLANS OF THE CONSTRUCTION WILL BE MONITORED WEEKLY BASIS. IF THE SAME IS NOT DONE IN THE LIKE THE LOCAL BODY SHALL REMOVE THE PLANS AND COST SHALL BE BORNE BY THE OWNER OF PLOT
2 DURING CONSTRUCTION IT IS MANDATORY ON THE PART OF THE OWNER TO PROPERLY SECURE THE CONSTRUCTION SITE OF MAIN ROAD BY MEANS OF CREATING A SCREEN WALL NOT LESS THAN 8 FT IN HEIGHT FROM GROUND LEVEL WHICH IS TO BE PAINTED TO AVOID IN PLEASANT APPEARANCE. THE SCREEN WALL MUST BE IN ADDITION TO THIS A NET OR SAME OTHER PROTECTIVE MATERIAL SHALL BE ADDED AT THE HAZARDS OF THE BUILDING TO ENSURE THAT ANY FALLING MATERIAL REMAINS WITHIN THE PROTECTED AREA
3 AGGIS RELATED ACTIVITIES WILL NOT BE TAKEN UP FOR CONSTRUCTION AT HEIGHT MORE THAN 8 m

NOTE:-
THE LIFT AND MACHINE ROOM SHALL BE AT FIRE LIFT STANDARD

FIRE SAFETY MEASURES
THE SERVICE NOT DEALING WITH PROVISION OF PROPER FIRE SAFETY MEASURES IN THE MULTI STOREY BUILDINGS CONFORMING TO THE PROVISIONS OF RULES THEREUNDER AND THE SAME SHALL BE GOT CERTIFIED FROM THE COMPETENT AUTHORITY
ELECTRIC SUB STATION / GENERATOR ROOM IF PROVIDED SHOULD BE ON SOLID GROUND NEAR, ISOLATE CONTROL PANEL ON GROUND FLOOR OR IN UPPER BASEMENT AND IT SHOULD BE LOCATED THE OUTER PERIMETER OF THE BUILDING THE SAME SHOULD BE GOT APPROVED FROM THE COMPETENT AUTHORITY

SOLAR WATER HEATING SYSTEM
THE PROVISION OF SOLAR WATER HEATING SYSTEM SHALL BE AS PER NORMS SPECIFIED BY CAMPA & MNES SHALL BE MADE OPERATIONAL IN EACH BUILDING BLOCK BEFORE APPLYING FOR AN OCCUPATION CERTIFICATE

RAIN WATER HARVESTING SYSTEM
THE RAIN WATER HARVESTING SYSTEM SHALL BE PROVIDED AS PER CENTRAL GROUND WATER AUTHORITY NORMS/HARYANA GROVE NOTIFICATION AS APPLICABLE

NOTE
ALL TOILETS ARE MECHANICALLY LIT AND VENTILATED

NOTES
1 GATE AND BOUNDARY WALL AS STD DESIGN
2 EXHAUST FAN TO BE PROVIDED IN ALL KITCHENS & TOILETS
3 SPRINKLERS TO BE PROVIDED IN THE PREMISES AS PER NBC NORMS
4 100% POWER BACKUP FOR RUNNING THE EMERGENCY SERVICES
5 TOILETS & POWDER ROOMS ARE MECHANICALLY VENTILATED AND LIT
6 BASEMENT ARE MECHANICALLY VENTILATED AND LIT
7 SERVICE AREA & LIFT ARE 100% POWER BACKUP

REVISED
ALREADY SANCTIONED

Checked subject to comments in forwarding letter No. 1122 Dt. 6/6/2012 and same attached with the estimate

Superintending Engineer for Chief Engineer HSVP Panchkula

Director
Town and Country Planning, Haryana, Chandigarh

ROAD LAYOUT

For Shivanandan Buildtech Pvt. Ltd
Director

Executive Engineer
HSVP Division No.
Gurugram

(BALWANT SINGH)
S.D.

OWNERS SIGN.	ARCHITECT'S SIGN.
Director	ARCHITECT RAJEEV JAIN CAMPUS/HR

Project
REVISED & PROPOSED BUILDING PLANS OF GROUP HOUSING SCHEME AREA MEASURING 13.32 ACRE LICENCE NO.79 OF 2011 DATED 22.07.2011 & LICENCE NO.80 OF 2010 DATED 21.09.2010 IN SECTOR 86 GURGAON MANESAR LURAN COMPLEX

Client
M/S SHIVANANDAN BUILDTECH PVT. LTD

SCALE	AS SHOWN
DATE	27-JUNE-2013
DRAWN	K.J.
CHECKED	
APPROVED	
DWG. NO.	01
REV. NO.	REV.R0

SUBMISSION DRAWING

Checked and Subject to Public Health Branch Service fully subject to comments in forwarding letter No. 2010/PH(S)-GURGAON

Superintending Engineer (PH) HSVP, Panchkula

Ichinen
ARCHITECTS PRIVATE LIMITED
A-13, SARSWATI ENCLAVE, NEW DELHI
TELEPHONE +91 11 46028810, EMAIL: ichinen@vsnl.net

Asst. Chief Engineer (PH) HSVP, Gurgaon

NOTE:
THE OWNER IS PERFECT OF CARPET AREA PROVIDED AT 2% AND ARE NOT OR PARTS OF CARPET AREA OR OTHER CARPET AREA WHICH IS WHOLLY BEYOND PERMISSION OF THE PROVIDED

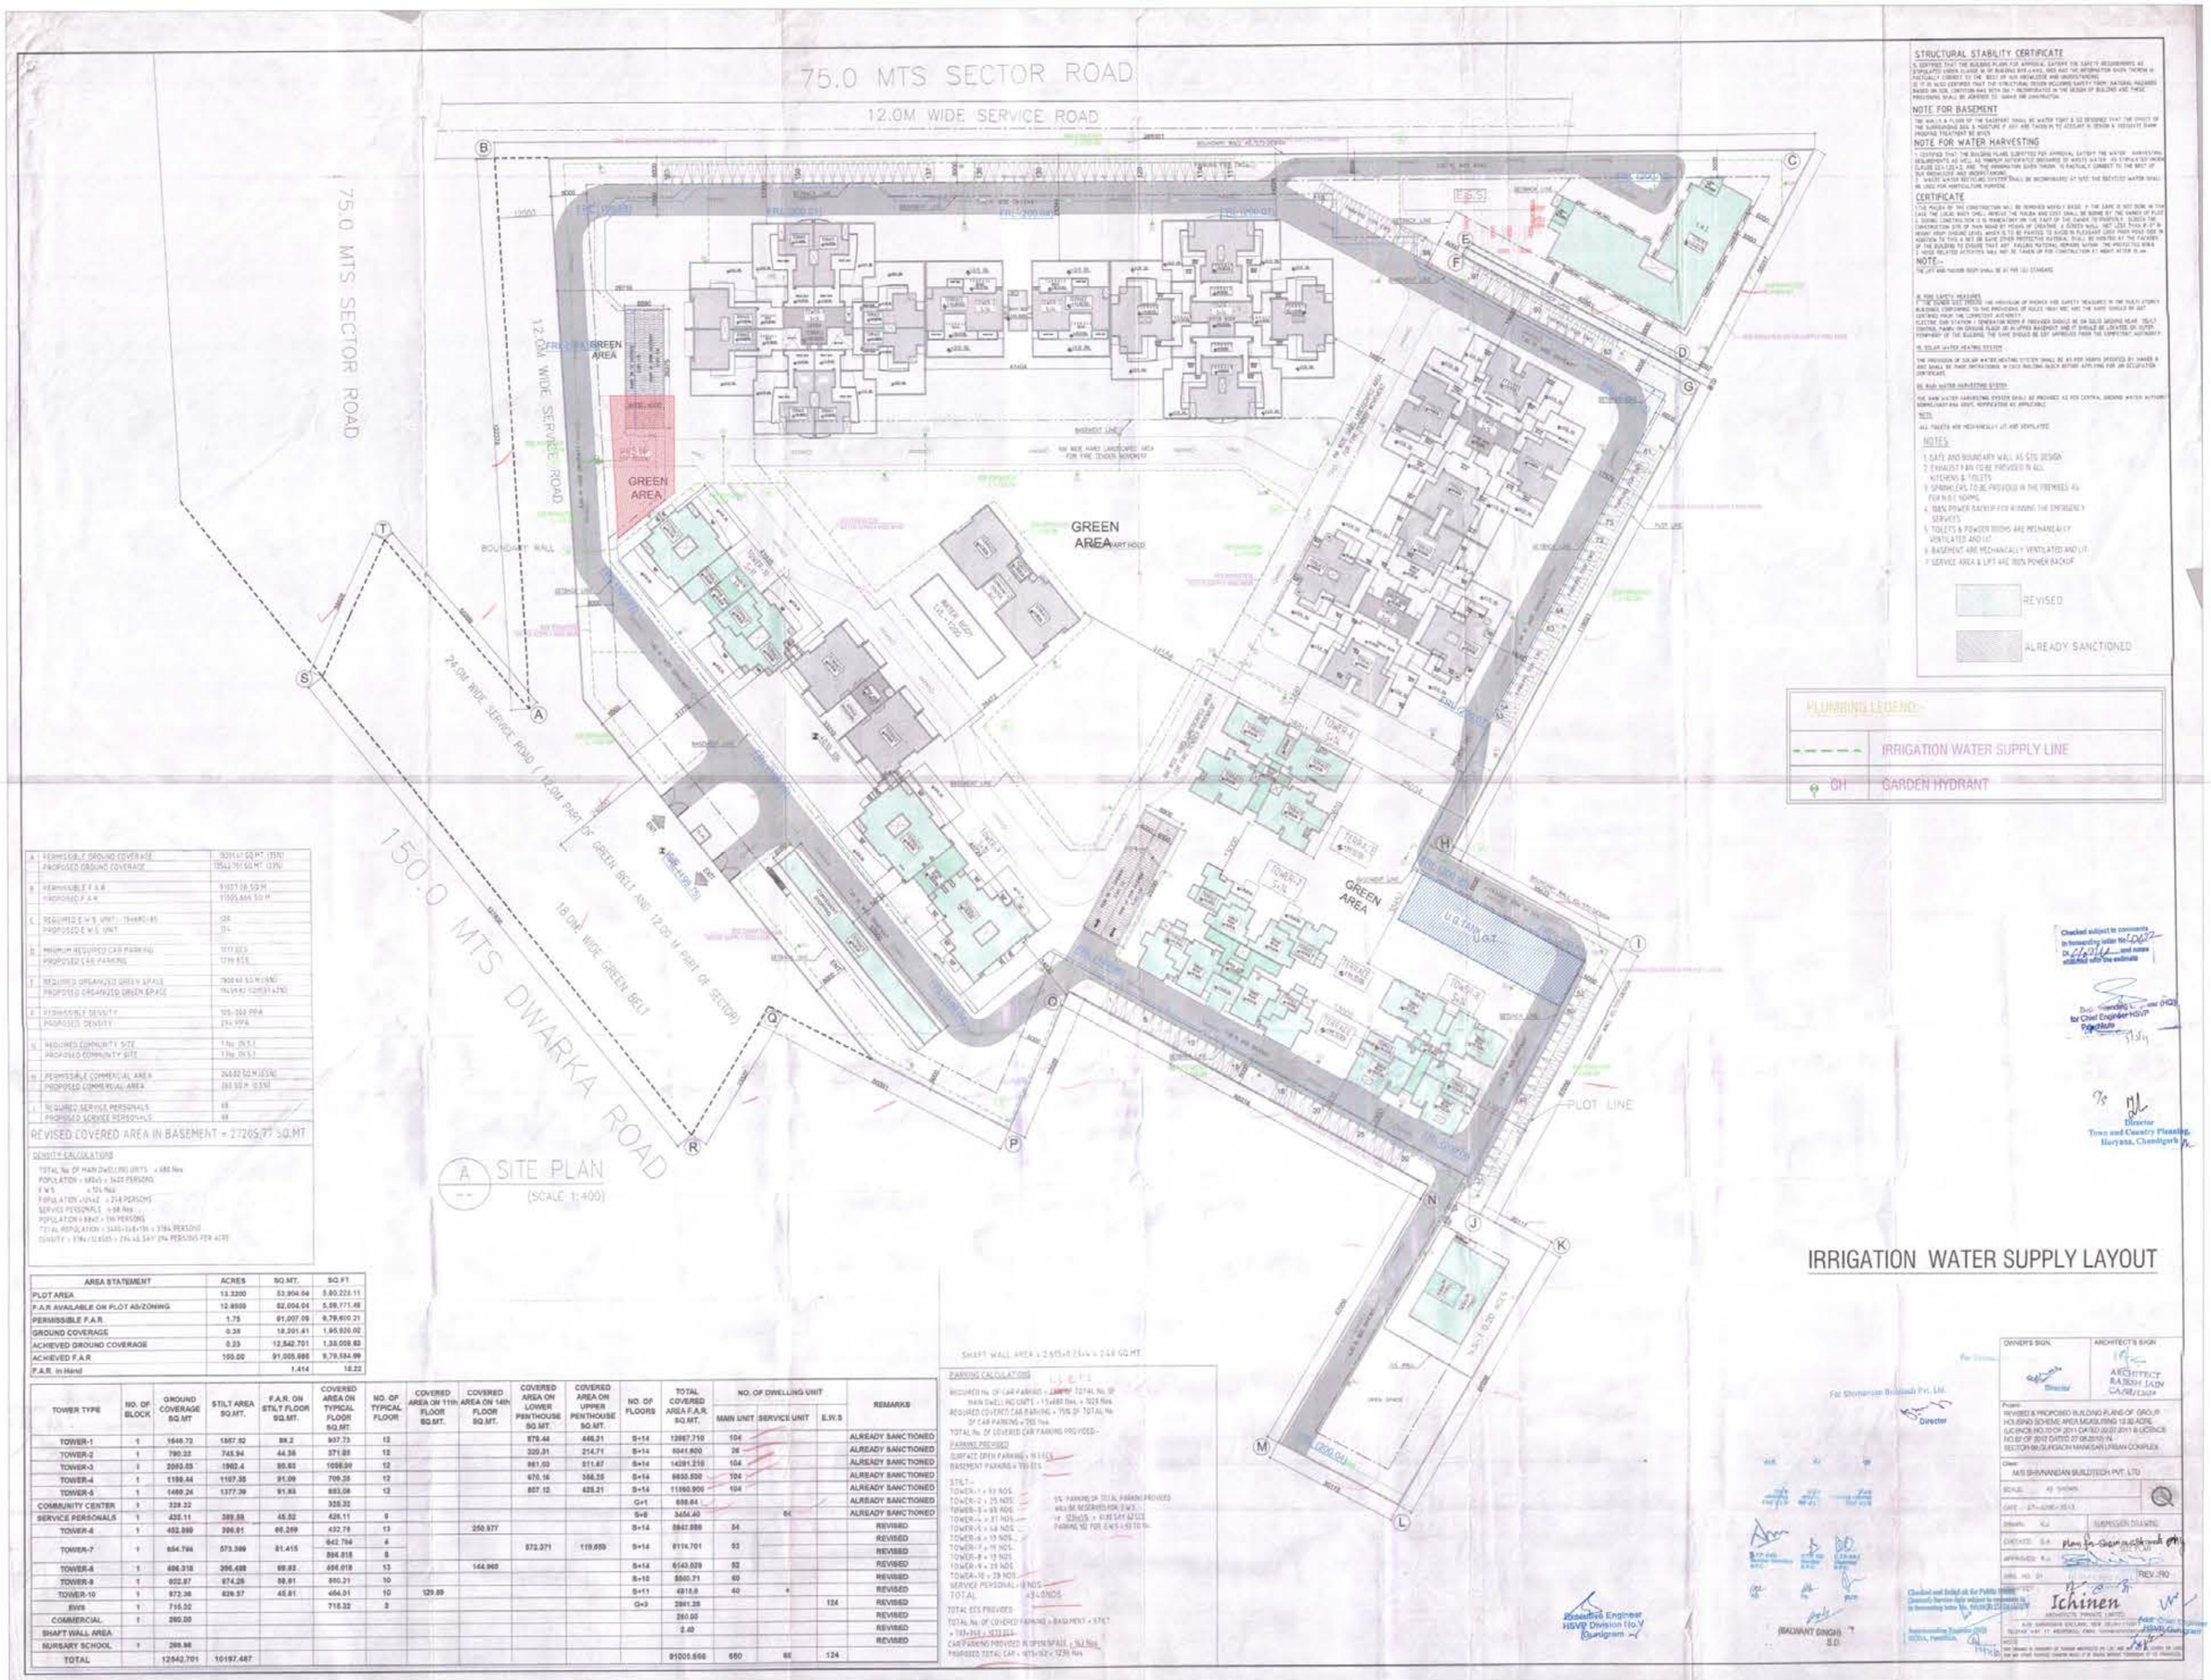

I	REQUIRED SERVICE PERSONALS PROPOSED SERVICE PERSONALS	68 68

REVISED COVERED AREA IN BASEMENT = 27205.77 SQ.MT

DENSITY CALCULATIONS

TOTAL No. OF MAIN DWELLING UNITS = 680 Nos
POPULATION = 680x5 = 3400 PERSONS
E.W.S = 5% Nos
POPULATION (EWS) = 214 PERSONS
SERVICE PERSONALS = 68 Nos
POPULATION (RENT) = 170 PERSONS
TOTAL POPULATION = 3400+214+170 = 3784 PERSONS
DENSITY = 3784/12.8505 = 294.46 SAY 296 PERSONS PER ACRE

AREA STATEMENT	ACRES	SQ.MT.	SQ.FT
PLOT AREA	13.3200	53,904.04	5,80,223.11
F.A.R AVAILABLE ON PLOT AS/ZONING	12.8500	52,004.04	5,59,771.48
PERMISSIBLE F.A.R	1.75	91,007.08	9,79,610.21
GROUND COVERAGE	0.38	18,201.41	1,95,920.02
ACHIEVED GROUND COVERAGE	0.33	12,542.701	1,35,059.63
ACHIEVED F.A.R	100.00	91,005.896	9,79,584.99
F.A.R. in Hand		1.414	18.22

TOWER TYPE	NO. OF BLOCK	GROUND COVERAGE SQ.MT	STILT AREA SQ.MT.	F.A.R. ON STILT FLOOR SQ.MT.	COVERED AREA ON TYPICAL FLOOR SQ.MT.	NO. OF TYPICAL FLOOR	COVERED AREA ON 11th FLOOR SQ.MT.	COVERED AREA ON 14th FLOOR SQ.MT.	COVERED AREA ON LOWER PENTHOUSE SQ.MT.	COVERED AREA ON UPPER PENTHOUSE SQ.MT.	NO. OF FLOORS	TOTAL COVERED AREA F.A.R. SQ.MT.	NO. OF DWELLING UNIT			REMARKS
													MAIN UNIT	SERVICE UNIT	E.W.S	
TOWER-1	1	1646.72	1867.02	89.2	937.73	12			879.44	446.21	S+14	12067.710	104			ALREADY SANCTIONED
TOWER-2	1	790.22	745.94	44.36	371.83	12			320.31	214.71	S+14	6041.600	28			ALREADY SANCTIONED
TOWER-3	1	2093.03	1902.4	90.63	1058.99	12			861.03	511.87	S+14	14291.210	104			ALREADY SANCTIONED
TOWER-4	1	1198.44	1107.35	91.09	709.28	12			670.16	368.25	S+14	8650.930	104			ALREADY SANCTIONED
TOWER-5	1	1480.24	1377.39	91.85	883.08	12			807.12	625.21	S+14	11160.900	104			ALREADY SANCTIONED
COMMUNITY CENTER	1	338.32			338.32						G+1	676.64				ALREADY SANCTIONED
SERVICE PERSONALS	1	426.11	389.59	45.52	426.11	8					S+8	3454.40		64		ALREADY SANCTIONED
TOWER-6	1	402.899	396.81	60.299	432.78	13		250.977			S+14	5842.880	54			REVISED
TOWER-7	1	654.704	573.399	81.415	842.764	4			572.371	119.859	S+14	8114.701	52			REVISED
					894.018	8										REVISED
TOWER-8	1	606.316	396.488	99.82	656.018	13		144.960			S+14	8540.029	52			REVISED
TOWER-9	1	902.87	874.26	98.91	880.21	10					S+10	8800.71	40			REVISED
TOWER-10	1	872.38	826.57	45.81	464.01	10	129.89				S+11	4818.6	40	4		REVISED
EWS	1	715.32			715.32	3					G+3	2861.28			124	REVISED
COMMERCIAL	1	260.00										260.00				REVISED
SHAFT WALL AREA												2.40				REVISED
NURSARY SCHOOL	1	286.98														REVISED
TOTAL		12542.701	10197.487									91005.896	680	68	124	

SHAFT WALL AREA = 2.615x0.254 = 2.40 SQ.MT

PARKING CALCULATIONS

REQUIRED No. OF CAR PARKING = 1200/100 TOTAL No. OF MAIN DWELLING UNITS = 15x680 Nos. = 1020 Nos.
REQUIRED COVERED CAR PARKING = 75% OF TOTAL No. OF CAR PARKING = 765 Nos.
TOTAL No. OF COVERED CAR PARKING PROVIDED-
PARKING PROVIDED
COMPACT OPEN PARKING = 16 ECS
BASEMENT PARKING = 1163 ECS
STILT-
TOWER-1 = 53 NOS.
TOWER-2 = 25 NOS.
TOWER-3 = 53 NOS.
TOWER-4 = 37 NOS.
TOWER-5 = 54 NOS.
TOWER-6 = 15 NOS.
TOWER-7 = 15 NOS.
TOWER-8 = 15 NOS.
TOWER-9 = 29 NOS.
TOWER-10 = 29 NOS.
SERVICE PERSONALS = 8 NOS.
TOTAL = 234 NOS.
5% PARKING OF TOTAL PARKING PROVIDED WILL BE RESERVED FOR EWS
i.e. 1236x5 = 61.85 SAY 62 ECS
PARKING NO FOR EWS = 62 ECS
TOTAL ECS PROVIDED
TOTAL No. OF COVERED PARKING = BASEMENT + STILT
= 1163+234 = 1397 ECS
CAR PARKING PROVIDED IN OPEN SPACE = 182 Nos.
PROPOSED TOTAL CAR = 1397+182 = 1579 Nos.

STRUCTURAL STABILITY CERTIFICATE

IS CERTIFIED THAT THE BUILDING PLANS FOR APPROVAL, SATISFY THE SAFETY REQUIREMENTS AS PRESCRIBED UNDER CLAUSE 10 OF BUILDING BYE-LAWS, 1965 AND THE INFORMATION GIVEN THEREIN IS FACTUALLY CORRECT TO THE BEST OF OUR KNOWLEDGE AND UNDERSTANDING.
IS IT IS ALSO CERTIFIED THAT THE STRUCTURAL DESIGN INCLUDING SAFETY FROM NATURAL HAZARDS BASED ON SOIL CONDITION HAS BEEN DULY INCORPORATED IN THE DESIGN OF BUILDING AND THESE PROVISIONS SHALL BE ADHERED TO DURING THE CONSTRUCTION.

NOTE FOR BASEMENT

THE WALLS & FLOOR OF THE BASEMENT SHALL BE WATER TIGHT & SO DESIGNED THAT THE EFFECT OF THE SURROUNDING SOIL & MOISTURE IT ACT AND TAKEN INTO ACCOUNT IN DESIGN & ADEQUATE DAMP PROOFING TREATMENT BE GIVEN

NOTE FOR WATER HARVESTING

1. CERTIFIED THAT THE BUILDING PLANS SUBMITTED FOR APPROVAL SATISFY THE WATER HARVESTING REQUIREMENTS AS WELL AS PROVIDE AUTOMATIC DIVERSION OF WASTE WATER AS STIPULATED UNDER CLAUSE 22.4.1,22.4.2, AND THE INFORMATION GIVEN THEREIN IS FACTUALLY CORRECT TO THE BEST OF OUR KNOWLEDGE AND UNDERSTANDING.
2. WASTE WATER RECYCLING SYSTEM SHALL BE INCORPORATED AT SITE THE RECYCLED WATER SHALL BE USED FOR HORTICULTURE PURPOSE.

CERTIFICATE

1. THE PLACE OF THE CONSTRUCTION WILL BE REMOVED WEEKLY BASIS. IF THE SAME IS NOT DONE IN THE CASE THE LOCAL BODY SHALL REMOVE THE PLACE AND COST SHALL BE BORNE BY THE OWNER OF PLOT.
2. DURING CONSTRUCTION IT IS MANDATORY ON THE PART OF THE OWNER TO PROTECT SURROUNDING CONSTRUCTION SITE OF MAIN ROAD BY MEANS OF CREATING A SCREEN WALL NOT LESS THAN 8'-0" IN HEIGHT FROM GROUND LEVEL WHICH IS TO BE PAINTED TO AVOID IN PLEASANT LOOK FROM POLE SIDE IN ADDITION TO THIS A NET OR SAME OTHER PROTECTIVE MATERIAL SHALL BE ERECTED AT THE FACADES OF THE BUILDING TO ENSURE THAT ANY FALLING MATERIAL REMAINS WITHIN THE PROTECTED AREA.
3. NOISE POLLUTED ACTIVITIES WILL NOT BE TAKEN UP FOR CONSTRUCTION AT NIGHT AFTER 10 pm

NOTE:-

THE LIFT AND PASSENGER SHALL BE AS PER IS.14700 STANDARD

IX FIRE SAFETY MEASURES
THE OWNER WILL ENSURE THE PROVISION OF PROPER FIRE SAFETY MEASURES IN THE MULTI STOREY BUILDINGS CONFORMING TO THE PROVISIONS OF RULES WHICH ARE THE SAME SHALL BE GOT CERTIFIED FROM THE CORRECTION AUTHORITY.
ELECTRIC SUB STATION / GENERATOR ROOM IF PROVIDED SHOULD BE ON SOLID GROUND NEAR ISOLATE CONTROL PANEL ON GROUND FLOOR OR IN UPPER BASEMENT AND IT SHOULD BE LOCATED ON OUTER PERIMETER OF THE BUILDING THE SAME SHOULD BE GOT APPROVED FROM THE CORRECTION AUTHORITY

XI SOLAR WATER HEATING SYSTEM

THE PROVISION OF SOLAR WATER HEATING SYSTEM SHALL BE AS PER NORMS SPECIFIED BY HAREDA AND SHALL BE TAKEN INTERNATIONAL IN CASE BUILDING PLAN BEFORE APPLYING FOR AN OCCUPATION CERTIFICATE.

XII RAIN WATER HARVESTING SYSTEM

THE RAIN WATER HARVESTING SYSTEM SHALL BE PROVIDED AS PER CENTRAL GROUND WATER AUTHORITY NORMS/HARYANA GOVT. NOTIFICATION AS APPLICABLE

NOTE:
ALL TOILETS ARE MECHANICALLY LIT AND VENTILATED

NOTES

1. GATE AND BOUNDARY WALL AS STD DESIGN
2. EXHAUST FAN TO BE PROVIDED IN ALL KITCHENS & TOILETS
3. SPRINKLERS TO BE PROVIDED IN THE PREMISES AS PER N.B.C NORMS
4. 100% POWER BACKUP FOR RUNNING THE EMERGENCY SERVICES
5. TOILETS & POWDER ROOMS ARE MECHANICALLY VENTILATED AND LIT
6. BASEMENT ARE MECHANICALLY VENTILATED AND LIT
7. SERVICE AREA & LIFT ARE 100% POWER BACKUP

REVISED

ALREADY SANCTIONED

PLUMBING LEGEND:-	
- - - - -	IRRIGATION WATER SUPPLY LINE
GH	GARDEN HYDRANT

IRRIGATION WATER SUPPLY LAYOUT

Checked subject to comments in forwarding letter No. LD-622 Dt. 6/6/14 and notes entered into the estimate

Executive Engineer (HQ) for Chief Engineer HSVP Panchkula 7/5/14

Director Town and Country Planning, Haryana, Chandigarh

Executive Engineer HSVP Division No.V Gurugram

(BALWANT SINGH) S.D.

For Shivnandan Buildtech Pvt. Ltd. Director

OWNER'S SIGN. — Director

ARCHITECT'S SIGN. — ARCHITECT RAJESH JAIN CA/88/13604

Project: REVISED & PROPOSED BUILDING PLANS OF GROUP HOUSING SCHEME AREA measuring 13.32 ACRE (LICENCE NO.70 OF 2011 DATED 20.07.2011 & LICENCE NO.58 OF 2012 DATED 27.08.2012) IN SECTOR-99 GURGAON MANESAR URBAN COMPLEX

Client: M/S SHIVNANDAN BUILDTECH PVT. LTD.

SCALE: AS SHOWN

DATE: 27-JUNE-2014

Drawn: K.J. — SUBMISSION DRAWING

CHECKED: S.A. — Plans for change in shaft wall

APPROVED: K.J.

DWG. NO. 01 — REV.-R0

Checked and found ok for Public Health (Sewerage) Service Cell subject to comments in forwarding letter No. 10/PH/SE/2014/1/1/1

Superintending Engineer (HQ) HSVPA, Panchkula

Ichinen ARCHITECTS PRIVATE LIMITED

Addl. Chief Engineer HSVP, Chandigarh

NOTE: THE DRAWING IS OWNERSHIP OF ICHINEN ARCHITECTS PVT. LTD. AND CANNOT BE USED FOR ANY OTHER PURPOSE EXCEPT FOR WHICH IT IS MADE WITHOUT PERMISSION OF THE PROPRIETOR

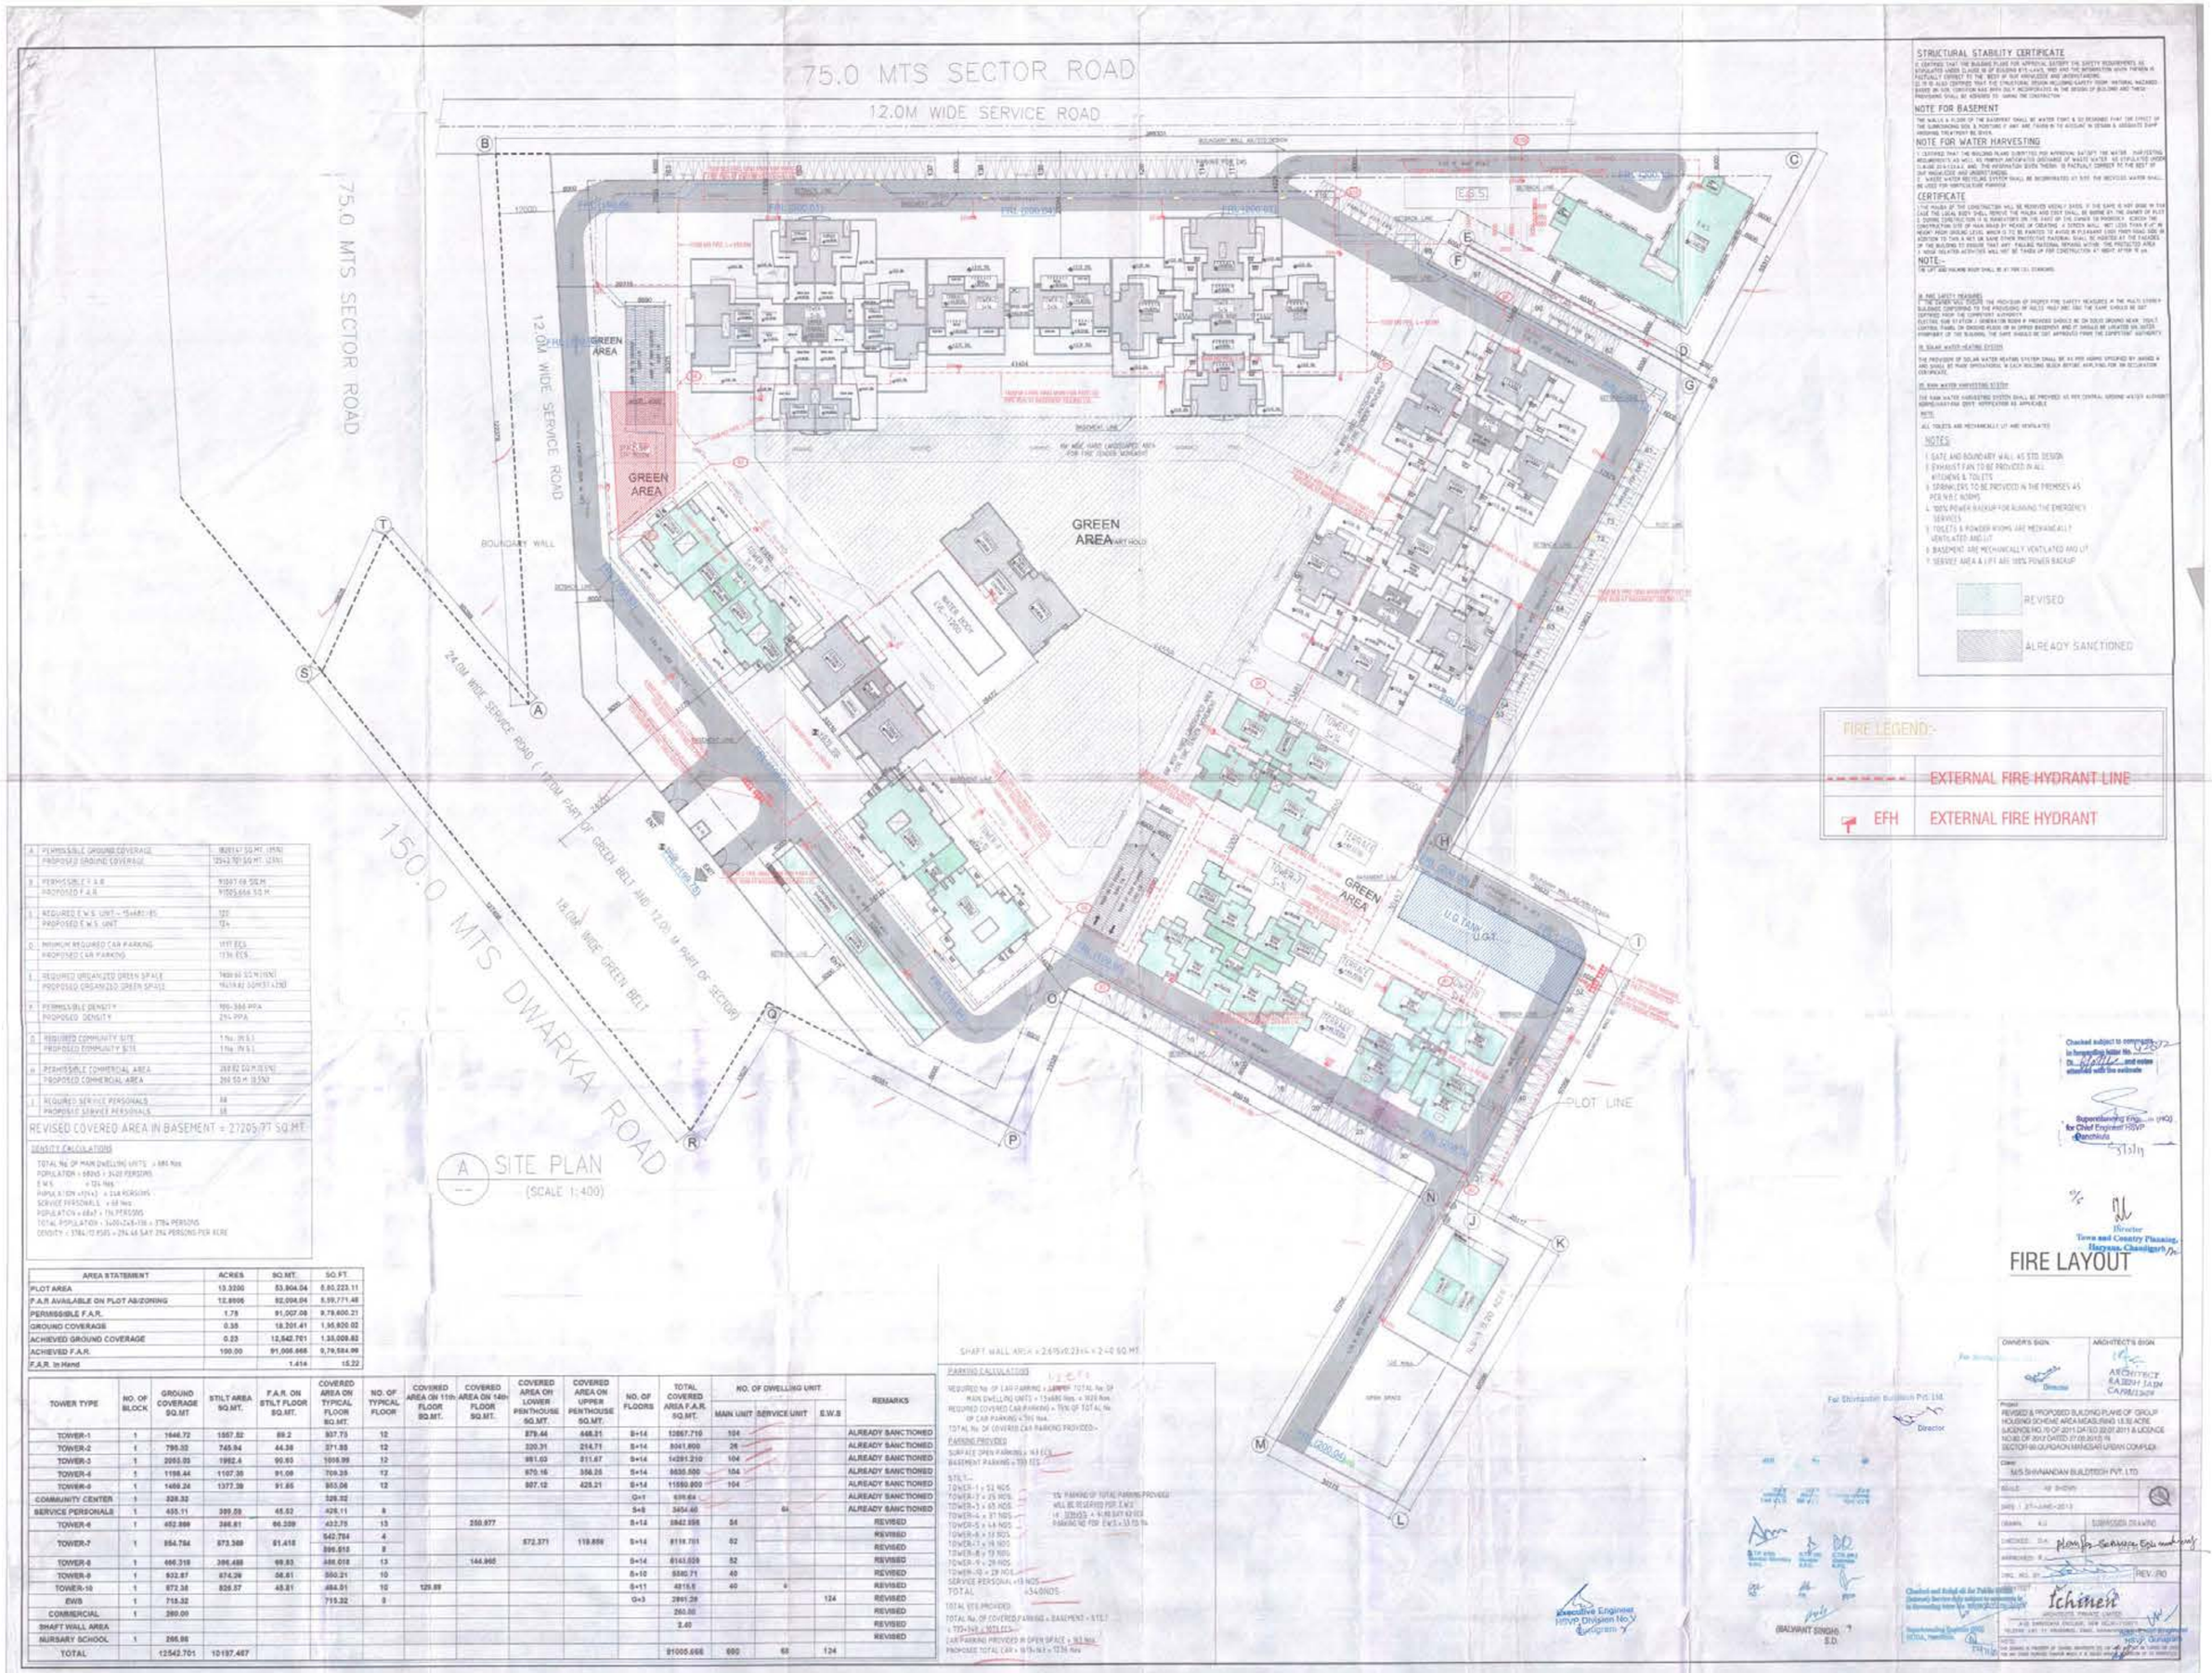

A	PERMISSIBLE GROUND COVERAGE PROPOSED GROUND COVERAGE	18,207.47 SQ.MT. (35%) 12,542.701 SQ.MT. (23%)
B	PERMISSIBLE F.A.R. PROPOSED F.A.R.	91,007.09 SQ.M. 91,005.666 SQ.M.
C	REQUIRED E.W.S. UNIT - 15+4+8=25 PROPOSED E.W.S. UNIT	120 124
D	MINIMUM REQUIRED CAR PARKING PROPOSED CAR PARKING	1177 ECS 1236 ECS
E	REQUIRED ORGANIZED GREEN SPACE PROPOSED ORGANIZED GREEN SPACE	7600.00 SQ.M. (15%) 16,218.82 SQ.M.(31.23%)
F	PERMISSIBLE DENSITY PROPOSED DENSITY	200-300 PPA 294 PPA
G	REQUIRED COMMUNITY SITE PROPOSED COMMUNITY SITE	1 No. (IN S.) 1 No. (IN S.)
H	PERMISSIBLE COMMERCIAL AREA PROPOSED COMMERCIAL AREA	2600.00 SQ.M.(5%) 200.00 M. (0.5%)
I	REQUIRED SERVICE PERSONALS PROPOSED SERVICE PERSONALS	68 68

REVISED COVERED AREA IN BASEMENT = 27205.77 SQ.MT.

DENSITY CALCULATIONS

TOTAL No. OF MAIN DWELLING UNITS = 684 Nos
POPULATION = 684x5 = 3420 PERSONS
E.W.S. = 124 Nos
POPULATION (124x4) = 496 PERSONS
SERVICE PERSONALS = 68 Nos
POPULATION = 68x7 = 476 PERSONS
TOTAL POPULATION = 3420+496+476 = 3784 PERSONS
DENSITY = 3784/12.9585 = 294.46 SAY 294 PERSONS PER ACRE

AREA STATEMENT	ACRES	SQ.MT.	SQ.FT.
PLOT AREA	13.3200	53,904.04	5,80,223.11
F.A.R AVAILABLE ON PLOT AB/ZONING	12.8906	92,094.04	9,59,771.48
PERMISSIBLE F.A.R.	1.75	91,007.09	9,79,600.21
GROUND COVERAGE	0.35	18,201.41	1,95,920.02
ACHIEVED GROUND COVERAGE	0.23	12,542.701	1,35,009.82
ACHIEVED F.A.R.	100.00	91,005.666	9,79,584.09
F.A.R. In Hand		1.414	15.22

TOWER TYPE	NO. OF BLOCK	GROUND COVERAGE SQ.MT	STILT AREA SQ.MT.	F.A.R. ON STILT FLOOR SQ.MT.	COVERED AREA ON TYPICAL FLOOR SQ.MT.	NO. OF TYPICAL FLOOR	COVERED AREA ON 11th FLOOR SQ.MT.	COVERED AREA ON 14th FLOOR SQ.MT.	COVERED AREA ON LOWER PENTHOUSE SQ.MT.	COVERED AREA ON UPPER PENTHOUSE SQ.MT.	NO. OF FLOORS	TOTAL COVERED AREA F.A.R. SQ.MT.	NO. OF DWELLING UNIT: MAIN UNIT	SERVICE UNIT	E.W.S	REMARKS
TOWER-1	1	1646.72	1557.52	89.2	937.75	12			879.44	448.31	B+14	12867.710	104			ALREADY SANCTIONED
TOWER-2	1	790.32	745.94	44.38	371.88	12			320.31	214.71	B+14	6041.800	26			ALREADY SANCTIONED
TOWER-3	1	2053.03	1992.4	60.63	1016.99	12			981.03	511.67	B+14	14291.210	104			ALREADY SANCTIONED
TOWER-4	1	1198.44	1107.35	91.09	709.26	12			670.16	356.25	B+14	8635.500	104			ALREADY SANCTIONED
TOWER-6	1	1409.24	1377.39	31.85	853.06	12			807.12	425.21	B+14	11550.800	104			ALREADY SANCTIONED
COMMUNITY CENTER	1	328.32			328.32						G+1	656.64				ALREADY SANCTIONED
SERVICE PERSONALS	1	455.11	409.59	45.52	426.11	8					S+8	3454.40		64		ALREADY SANCTIONED
TOWER-6	1	452.899	386.81	66.089	432.75	13		250.977			B+14	6842.598	54			REVISED
TOWER-7	1	854.784	873.369	81.415	542.784	4			572.371	119.859	B+14	8118.701	02			REVISED
					599.513	8										REVISED
TOWER-8	1	466.319	386.489	99.83	486.018	13		144.965			B+14	6143.039	52			REVISED
TOWER-9	1	532.87	474.29	58.61	550.21	10					B+10	5580.71	40			REVISED
TOWER-10	1	572.38	526.57	45.81	484.01	10	129.89				B+11	4919.5	40	4		REVISED
EWS	1	715.32			715.32	3					G+3	2861.28			124	REVISED
COMMERCIAL	1	200.00										200.00				REVISED
SHAFT WALL AREA												2.40				REVISED
NURSARY SCHOOL	1	286.98														REVISED
TOTAL		12542.701	10197.467									91005.666	690	68	124	

SHAFT WALL AREA = 2.4/5x0.23Hx = 2.40 SQ.MT.

PARKING CALCULATIONS

REQUIRED No. OF CAR PARKING = 1.5 PER TOTAL No. OF MAIN DWELLING UNITS = 1.5x684 Nos. = 1026 Nos.
REQUIRED COVERED CAR PARKING = 15% OF TOTAL No. OF CAR PARKING = 154 Nos.
TOTAL No. OF COVERED CAR PARKING PROVIDED=

PARKING PROVIDED

SURFACE OPEN PARKING = 143 ECS
BASEMENT PARKING = 993 ECS
STILT:-
TOWER-1 = 51 NOS.
TOWER-2 = 25 NOS.
TOWER-3 = 63 NOS.
TOWER-4 = 37 NOS.
TOWER-5 = 44 NOS.
TOWER-6 = 55 NOS.
TOWER-7 = 16 NOS.
TOWER-8 = 13 NOS.
TOWER-9 = 28 NOS.
TOWER-10 = 29 NOS.
SERVICE PERSONAL = 18 NOS.
TOTAL = 348 NOS.

15% PARKING OF TOTAL PARKING PROVIDED WILL BE RESERVED FOR E.W.S. (i.e. 30 NOS) = 9+30 SAY 42 ECS PARKING NO FOR E.W.S = 33.73 %

TOTAL ECS PROVIDED
TOTAL No. OF COVERED PARKING = BASEMENT + STILT = 993+348 = 1341 ECS
CAR PARKING PROVIDED IN OPEN SPACE = 143 Nos.
PROPOSED TOTAL CAR = 1341+143 = 1236 Nos.

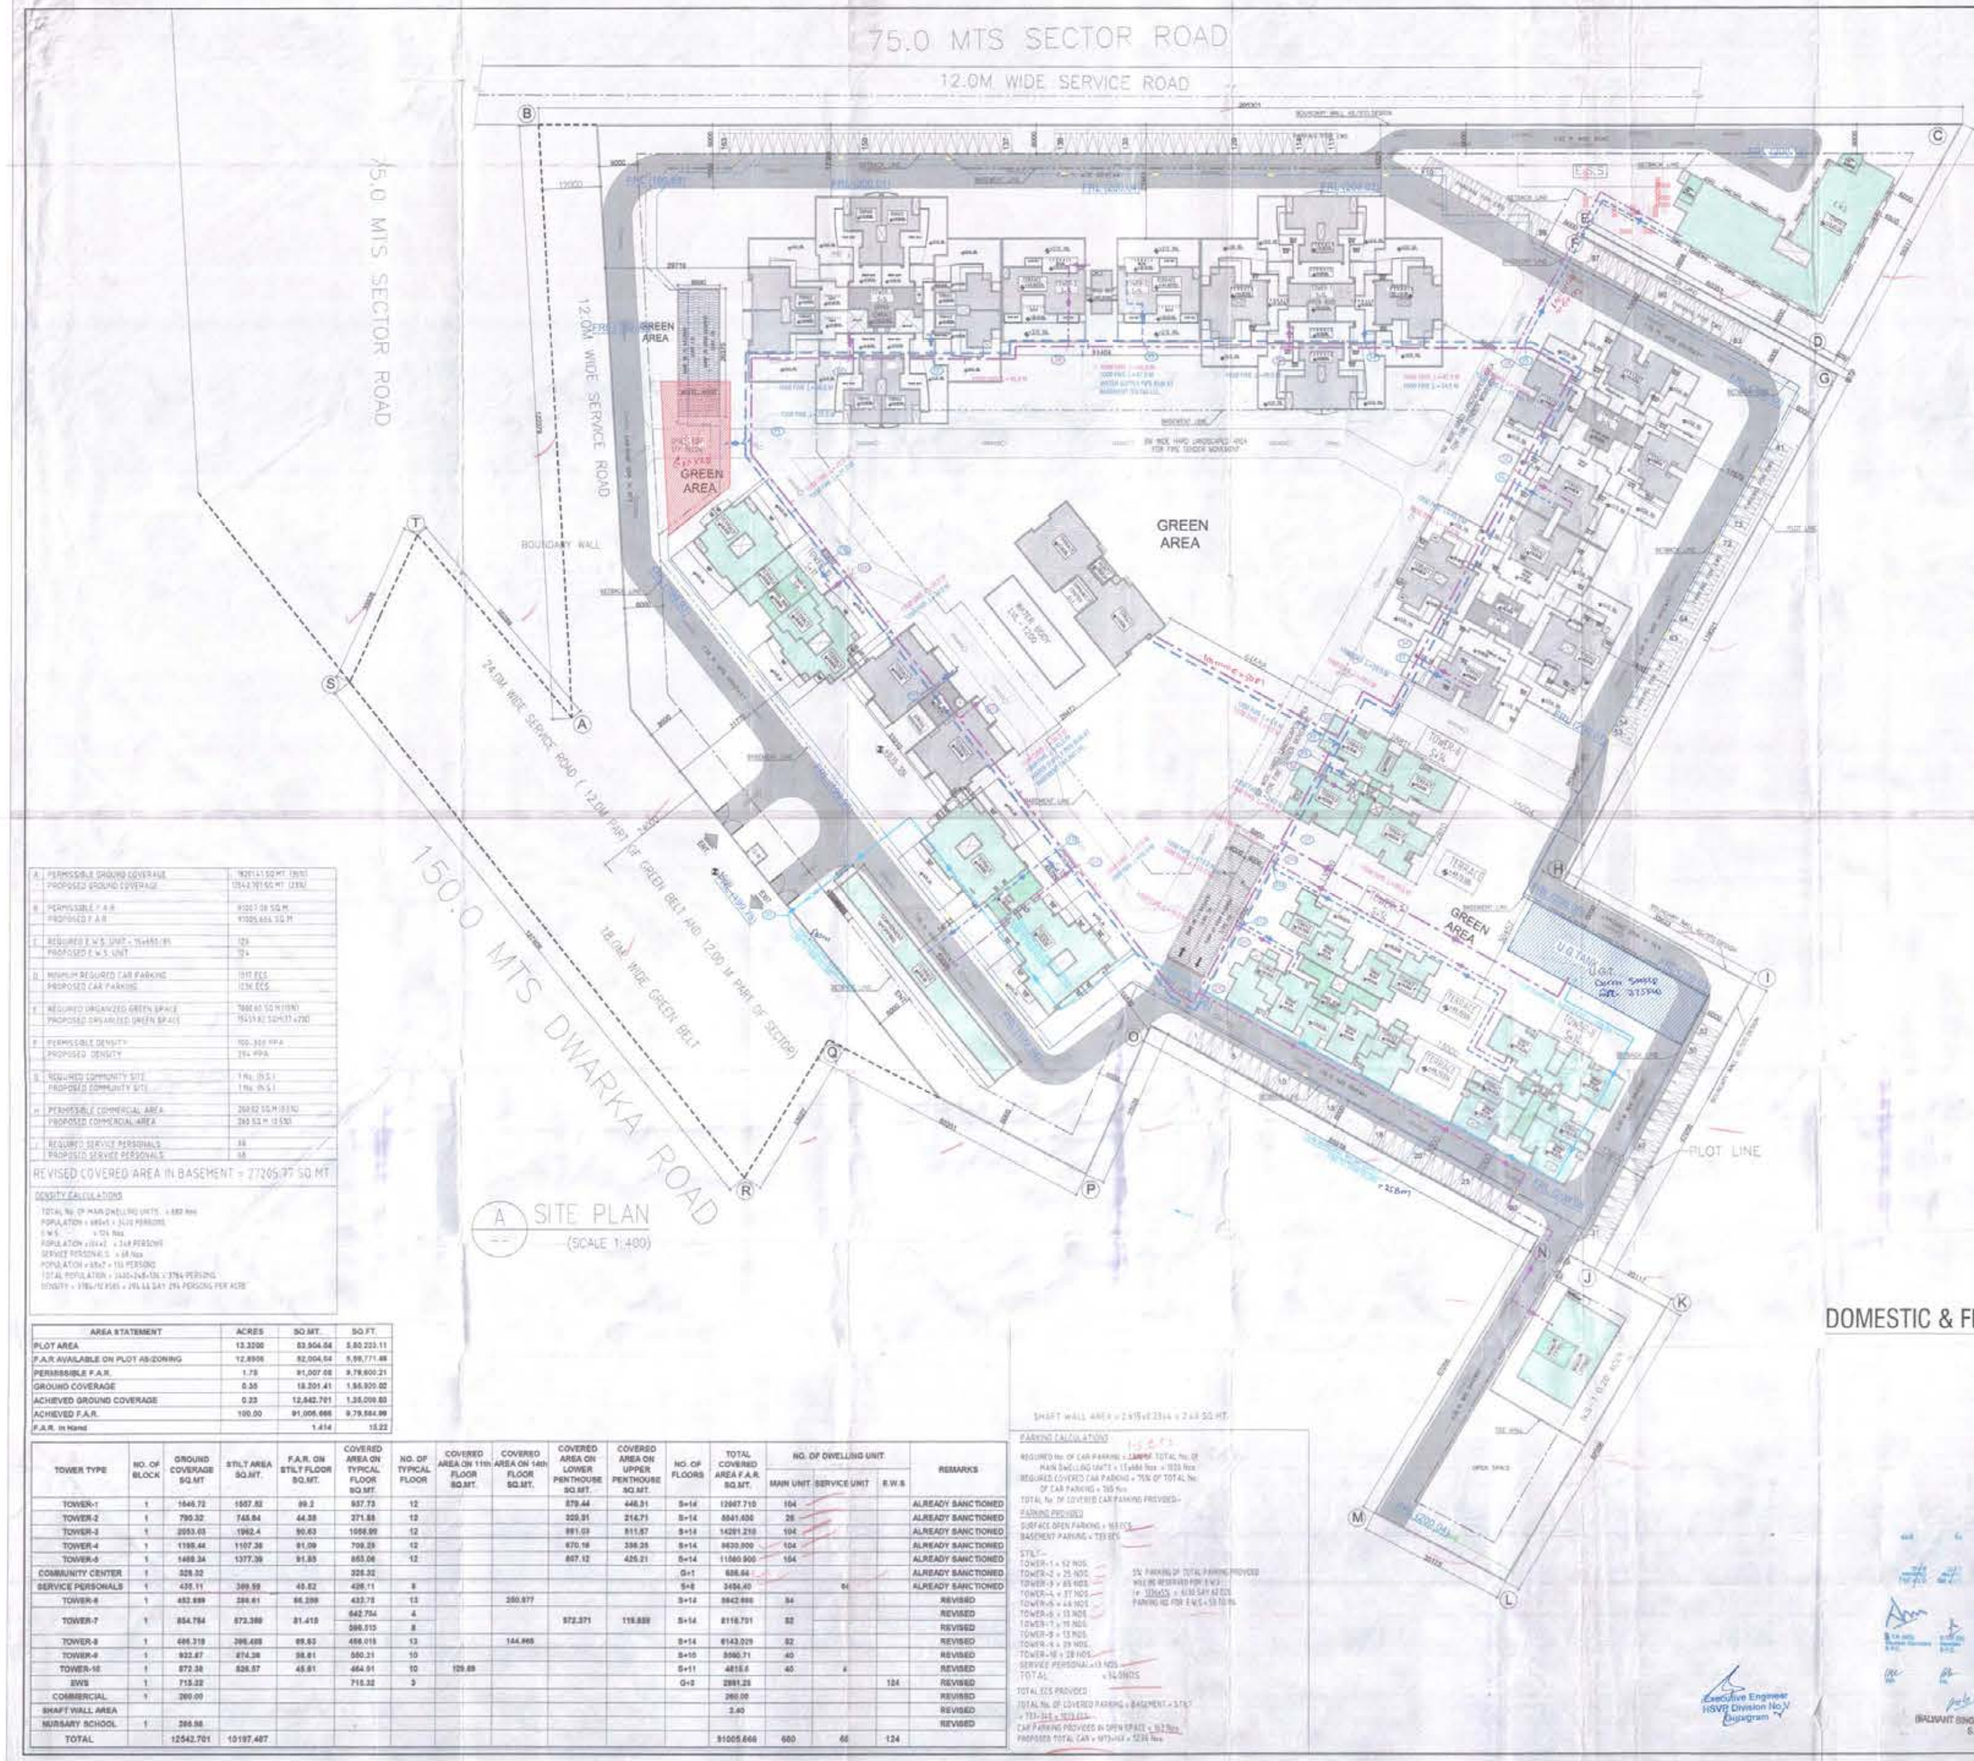

A SITE PLAN
(SCALE 1:400)

A	PERMISSIBLE GROUND COVERAGE PROPOSED GROUND COVERAGE	182014.1 SQ MT. (35%) 1354.4 701.50 MT. (23%)
B	PERMISSIBLE F.A.R PROPOSED F.A.R	91007.08 SQ.M 91005.666 SQ.M
C	REQUIRED E.W.S. UNIT - 15%(85.8%) PROPOSED E.W.S. UNIT	129 124
D	MINIMUM REQUIRED CAR PARKING PROPOSED CAR PARKING	1117 ECS 1236 ECS
E	REQUIRED ORGANIZED GREEN SPACE PROPOSED ORGANIZED GREEN SPACE	7000.60 SQ.M (15%) 15433.92 SQM.(33.42%)
F	PERMISSIBLE DENSITY PROPOSED DENSITY	100-200 PPA 194 PPA
G	REQUIRED COMMUNITY SITE PROPOSED COMMUNITY SITE	1 No. (N.S.) 1 No. (N.S.)
H	PERMISSIBLE COMMERCIAL AREA PROPOSED COMMERCIAL AREA	260.02 SQ.M (15%) 260.53 M (15.5%)
I	REQUIRED SERVICE PERSONALS PROPOSED SERVICE PERSONALS	68 68

REVISED COVERED AREA IN BASEMENT = 27205.97 SQ.MT

DENSITY CALCULATIONS

TOTAL No. OF MAIN DWELLING UNITS = 680 Nos
POPULATION = 680x5 = 3400 PERSONS
E.W.S. = 124 Nos
POPULATION =124x5 = 620 PERSONS
SERVICE PERSONALS = 68 Nos
POPULATION = 68x2 = 136 PERSONS
TOTAL POPULATION = 3400+620+136 = 3756 PERSONS
DENSITY = 3756/19.4585 = 193.04 SAY 194 PERSONS PER ACRE

AREA STATEMENT	ACRES	SQ.MT.	SQ.FT.
PLOT AREA	13.3200	53,904.04	5,80,223.11
F.A.R AVAILABLE ON PLOT AS/ZONING	12.8906	52,004.04	5,59,771.48
PERMISSIBLE F.A.R.	1.75	91,007.08	9,79,600.21
GROUND COVERAGE	0.35	18,201.41	1,96,020.02
ACHIEVED GROUND COVERAGE	0.23	12,042.701	1,36,099.80
ACHIEVED F.A.R.	100.00	91,005.666	9,79,594.99
F.A.R. in Hamid		1.414	15.22

TOWER TYPE	NO. OF BLOCK	GROUND COVERAGE SQ.MT	STILT AREA SQ.MT.	F.A.R. ON STILT FLOOR SQ.MT.	COVERED AREA ON TYPICAL FLOOR SQ.MT.	NO. OF TYPICAL FLOOR	COVERED AREA ON 11th FLOOR SQ.MT.	COVERED AREA ON 14th FLOOR SQ.MT.	COVERED AREA ON LOWER PENTHOUSE SQ.MT.	COVERED AREA ON UPPER PENTHOUSE SQ.MT.	NO. OF FLOORS	TOTAL COVERED AREA F.A.R. SQ.MT.	NO. OF DWELLING UNIT			REMARKS
													MAIN UNIT	SERVICE UNIT	E.W.S	
TOWER-1	1	1046.72	1057.82	99.2	937.73	12			879.44	446.31	S+14	12907.710	104			ALREADY SANCTIONED
TOWER-2	1	790.32	745.84	44.38	371.88	12			320.31	214.71	S+14	8041.430	26			ALREADY SANCTIONED
TOWER-3	1	2053.03	1962.4	90.63	1058.99	12			991.03	511.57	S+14	14291.210	104			ALREADY SANCTIONED
TOWER-4	1	1199.44	1107.36	91.09	709.29	12			670.19	336.25	S+14	9630.000	104			ALREADY SANCTIONED
TOWER-5	1	1469.34	1377.39	91.95	853.06	12			807.12	425.21	S+14	11560.900	104			ALREADY SANCTIONED
COMMUNITY CENTER	1	328.32			328.32						G+1	656.64				ALREADY SANCTIONED
SERVICE PERSONALS	1	436.11	389.99	46.12	436.11	6					S+6	3494.40		64		ALREADY SANCTIONED
TOWER-6	1	452.889	384.61	68.289	433.73	13		380.977			S+14	5842.666	54			REVISED
TOWER-7	1	854.784	673.389	81.410	642.704	4			572.371	119.889	S+14	8118.701	52			REVISED
					598.015	8										REVISED
TOWER-8	1	496.319	396.409	99.93	466.015	13		144.965			S+14	6143.029	52			REVISED
TOWER-9	1	933.67	874.38	59.61	580.31	10					S+10	5980.71	40			REVISED
TOWER-10	1	872.38	826.57	45.81	464.91	10	129.89				S+11	4815.6	40	4		REVISED
EWS	1	715.32			715.32	3					G+2	2891.25			124	REVISED
COMMERCIAL	1	260.00										260.00				REVISED
SHAFT WALL AREA												2.40				REVISED
NURSARY SCHOOL	1	386.98														REVISED
TOTAL		12542.701	10197.487									91005.666	680	68	124	

SHAFT WALL AREA = 2.195x0.23x4 = 2.40 SQ.MT.

PARKING CALCULATIONS

REQUIRED No. OF CAR PARKING = 1.5 x 680 TOTAL No. OF MAIN DWELLING UNITS = 1.5x680 Nos = 1020 Nos
REQUIRED COVERED CAR PARKING = 75% OF TOTAL No. OF CAR PARKING = 765 Nos
TOTAL No. OF COVERED CAR PARKING PROVIDED=
PARKING PROVIDED
SURFACE GREEN PARKING = 187 ECS
BASEMENT PARKING = 1049 ECS

STILT:-
TOWER-1 = 52 NOS.
TOWER-2 = 25 NOS.
TOWER-3 = 65 NOS.
TOWER-4 = 37 NOS.
TOWER-5 = 44 NOS.
TOWER-6 = 13 NOS.
TOWER-7 = 19 NOS.
TOWER-8 = 13 NOS.
TOWER-9 = 29 NOS.
TOWER-10 = 28 NOS.
SERVICE PERSONAL = 13 NOS.
TOTAL = 16 SHOPS

5% PARKING OF TOTAL PARKING PROVIDED WILL BE RESERVED FOR E.W.S.
i.e. 16 SHOPS = 40.00 SAY 40 ECS
PARKING NO. FOR E.W.S = 50 ECS

TOTAL ECS PROVIDED
TOTAL No. OF COVERED PARKING = BASEMENT + STILT
= 1049 + 187 = 1236 ECS
CAR PARKING PROVIDED IN OPEN SPACE = 187 Nos
PROPOSED TOTAL CAR = 187+1049 = 1236 Nos

STRUCTURAL STABILITY CERTIFICATE

IT CERTIFIES THAT THE BUILDING PLANS FOR APPROVAL SATISFY THE SAFETY REQUIREMENTS AS STIPULATED UNDER CLAUSE 36 OF BUILDING BYE-LAWS, 1983 AND THE INFORMATION GIVEN THEREIN IS FACTUALLY CORRECT TO THE BEST OF OUR KNOWLEDGE AND UNDERSTANDING.
IT IS ALSO CERTIFIED THAT THE STRUCTURAL DESIGN INCLUDING SAFETY FROM NATURAL HAZARDS BASED ON SOIL CHARACTERISTICS WITH SELF INCORPORATED IN THE DESIGN OF BUILDING AND THESE PROVISIONS SHALL BE ADHERED TO DURING CONSTRUCTION

NOTE FOR BASEMENT

THE WALLS & FLOOR OF THE BASEMENT SHALL BE WATER TIGHT & IT IS REQUIRED THAT THE EFFECT OF THE SURROUNDING SOIL & WATERS IF ANY ARE TAKEN IN TO ACCOUNT IN DESIGN & ADEQUATE DAMP PROOFING TREATMENT BE GIVEN

NOTE FOR WATER HARVESTING

1. CERTIFIED THAT THE BUILDING PLANS SUBMITTED FOR APPROVAL SATISFY THE WATER HARVESTING REQUIREMENTS AS W.C., AS PROVIDED IMPORTED REFORMED, OF ACCEPT WATER AS STIPULATED UNDER CLAUSE 21.1.12.1.2. AND THE INFORMATION GIVEN THEREIN IS FACTUALLY CORRECT TO THE BEST OF OUR KNOWLEDGE AND UNDERSTANDING
2. WHERE WATER RECYCLING SYSTEM SHALL BE INCORPORATED, AT SITE THE RECYCLED WATER SHALL BE USED FOR AGRICULTURE PURPOSE.

CERTIFICATE

1. THE PHOTO OF THE CONSTRUCTION WILL BE PROVIDED MONTHLY BASIS, AFTER DAMP IS NOT DONE IN FOR LAKE THE LOCAL BODY SHALL REVOKE THE PLAN AND COST WILL BE BORNE BY THE OWNER OF PLOT
2. DURING CONSTRUCTION IT IS TRANSPORTED ON THE START OF THE DAMPER TO PROPOSED SITE OF THE CONSTRUCTION SITE OF MAIN ROAD BY MEANS OF CREATING A BORDER WALL NOT LESS THAN 8'-0" IN HEIGHT FROM GROUND LEVEL WHICH IS TO BE PAINTED TO GIVE IN PLEASANT LOOK FROM ROAD SIDE IN ADDITION TO THIS I AM OR SHALL OTHER PROTECTIVE MATERIAL SHALL BE ADOPTED AT THE FACADES OF THE BUILDING TO ENSURE THAT ANY FALLING MATERIAL REMAINS WITHIN THE PROTECTED AREA
3. WORK RELATED ACTIVITIES WILL NOT BE TAKEN UP AND CONSTRUCTION AT NIGHT AFTER 10 AM.

NOTE:-

THE LIFT AND MACHINE ROOM SHALL BE AT PER I.S. STANDARD

FIRE SAFETY MEASURES

1. THE OWNER WILL ENSURE THE PROVISION OF PROPER FIRE SAFETY MEASURES IN THE MULTI STOREY BUILDINGS CONFORMING TO THE PROVISIONS OF RULES 1983 AND AND THE SAFE SHIELD BE GOT SECTIONED FROM THE DIRECTORY AUTHORITY
ELECTRICAL SUB STATION - GENERATOR ROOM IF PROVIDED SHALL BE ON SOLID GROUND NEAR SELF CONTROL PANEL ON GROUND FLOOR OR IN UPPER BASEMENT AND IT SHALL BE LOCATED ON OUTER PERIPHERY OF THE BUILDING, THE SAME SHALL BE GOT APPROVED FROM THE DIRECTORY AUTHORITY

IV. SOLAR WATER HEATING SYSTEM

THE PROVISION OF SOLAR WATER HEATING SYSTEM SHALL BE AS PER NORMS SPECIFIED BY HAREDA AND SHALL BE MADE OPERATIONAL IN EACH BUILDING BLOCK BEFORE APPLYING FOR AN OCCUPATION CERTIFICATE

IV. RAIN WATER HARVESTING SYSTEM

THE RAIN WATER HARVESTING SYSTEM SHALL BE PROVIDED AS PER CENTRAL GROUND WATER AUTHORITY NORMS/HARYANA GOVT. NOTIFICATION AS APPLICABLE

NOTE:
ALL TOILETS ARE MECHANICALLY LIT AND VENTILATED

NOTES:
1. GATE AND BOUNDARY WALL AS STD DESIGN
2. EXHAUST FAN TO BE PROVIDED IN ALL KITCHENS & TOILETS
3. SPRINKLERS TO BE PROVIDED IN THE PREMISES AS PER N.B.C NORMS
4. 100% POWER BACKUP FOR RUNNING THE EMERGENCY SERVICES
5. TOILETS & POWDER ROOMS ARE MECHANICALLY VENTILATED AND LIT
6. BASEMENT ARE MECHANICALLY VENTILATED AND LIT
7. SERVICE AREA & LIFT ARE 100% POWER BACKUP

REVISED

ALREADY SANCTIONED

PLUMBING LEGEND:-

	DOMESTIC WATER SUPPLY LINE
	FLUSHING WATER SUPPLY LINE
	MUNICIPAL WATER SUPPLY LINE

Checked subject to comments in forwarding letter No. 32602 Dt. 6/10/11 and notes attached with the estimate

for Chief Engg. of HSVP

Director
Town and Country Planning, Haryana, Chandigarh

DOMESTIC & FLUSHING WATER SUPPLY LAYOUT

Executive Engineer
HSVP Division No.V
Gurugram

(BALWANT SINGH)
S.D.

OWNER'S SIGN. — Director
ARCHITECT'S SIGN. — ARCHITECT RAJESH JAIN CA/98/23024

For Shivnandan Buildtech Pvt. Ltd.
Director

Project: REVISED & PROPOSED BUILDING PLANS OF GROUP HOUSING SCHEME, AREA MEASURING 13.32 ACRE, LICENCE NO.10 OF 2011 DATED 02.02.2011 & LICENCE NO.59 OF 2012 DATED 27.08.2012 IN SECTOR-99A GURGAON MANESAR URBAN COMPLEX

Client: M/S SHIVNANDAN BUILDTECH PVT. LTD

SCALE: AS SHOWN
DATE: 27-JAN-2014
DRAWN: K.J. — SUBMISSION DRAWING
CHECKED: D.A. — Plans for service connection
APPROVED: K.J. — SITE PLAN
DRG. NO. 01 — REV. NO.

Ichinen
ARCHITECTS PRIVATE LIMITED
Add. Chief Engineer HSVP, Gurugram